


Table - 6

SUB-DIVISION of LOTS 4 & 5 - AMENDED PLAT of RIO VISTA

DOUGLAS COUNTY
OREGON

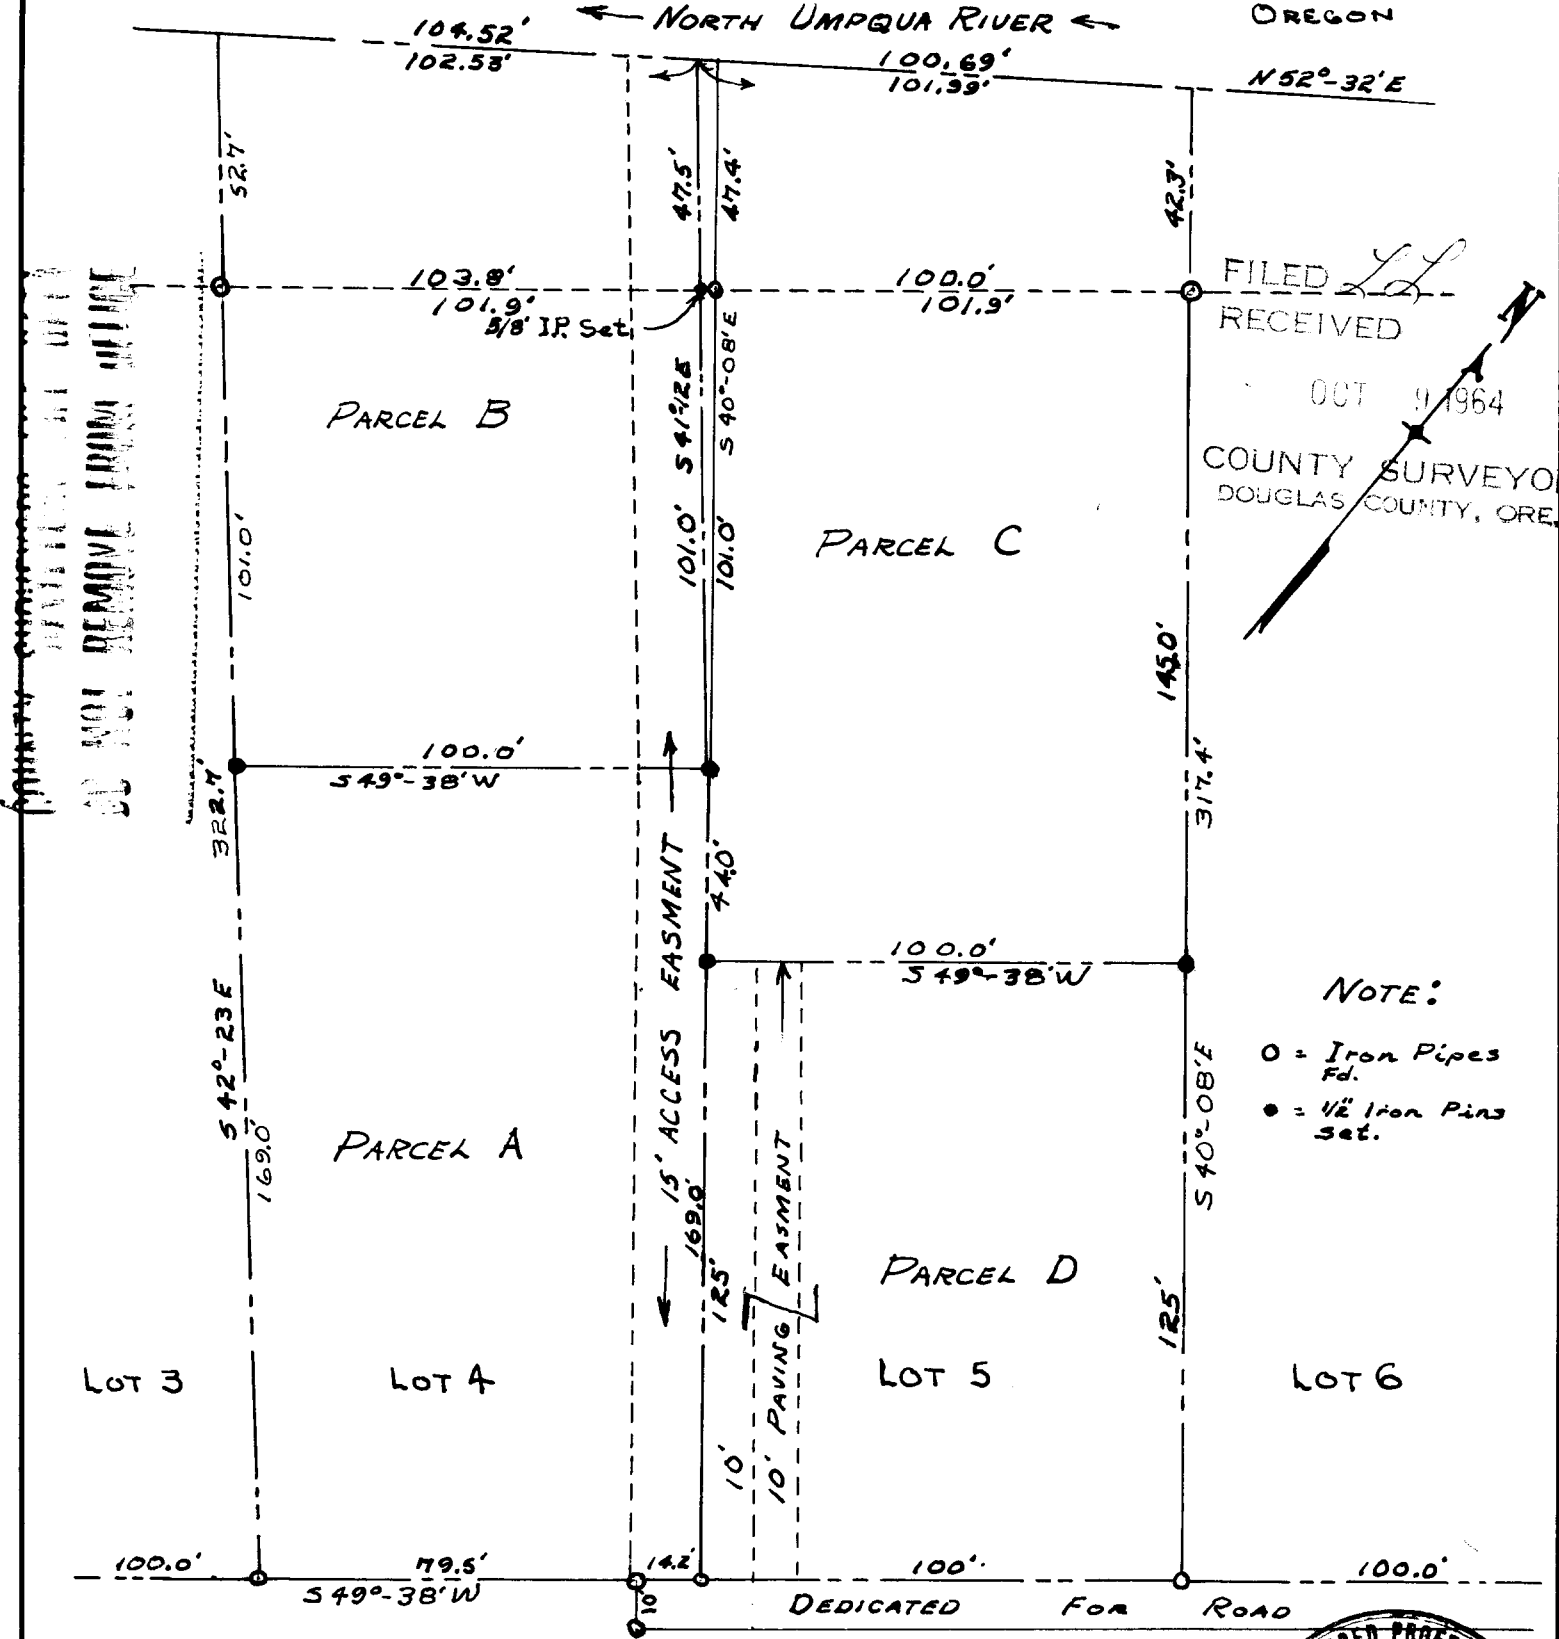


FILED *LL*
RECEIVED
OCT 9 1964
COUNTY SURVEYOR
DOUGLAS COUNTY, ORE.

NOTE:

- = Iron Pipes Fd.
- = 1/2" Iron Pins Set.

SCALE = 1" = 40'
SEPTEMBER 3, 1964

JAMES R. DAUGHERTY
CIVIL-SANITARY ENGINEER
WINSTON, OREGON

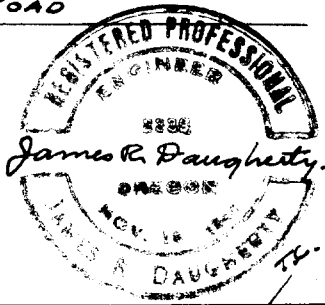

FOR RUTH BEADLEY