


SURVEY TO SET PROPERTY CORNERS
A PART OF LOT 1, BLOCK 60, ROSEBURG, ORE.
 SURVEYED FOR W.H. GERRETSON
 JUNE ~ 1965

T. 27-500 14-13

Samuel R. Rogers

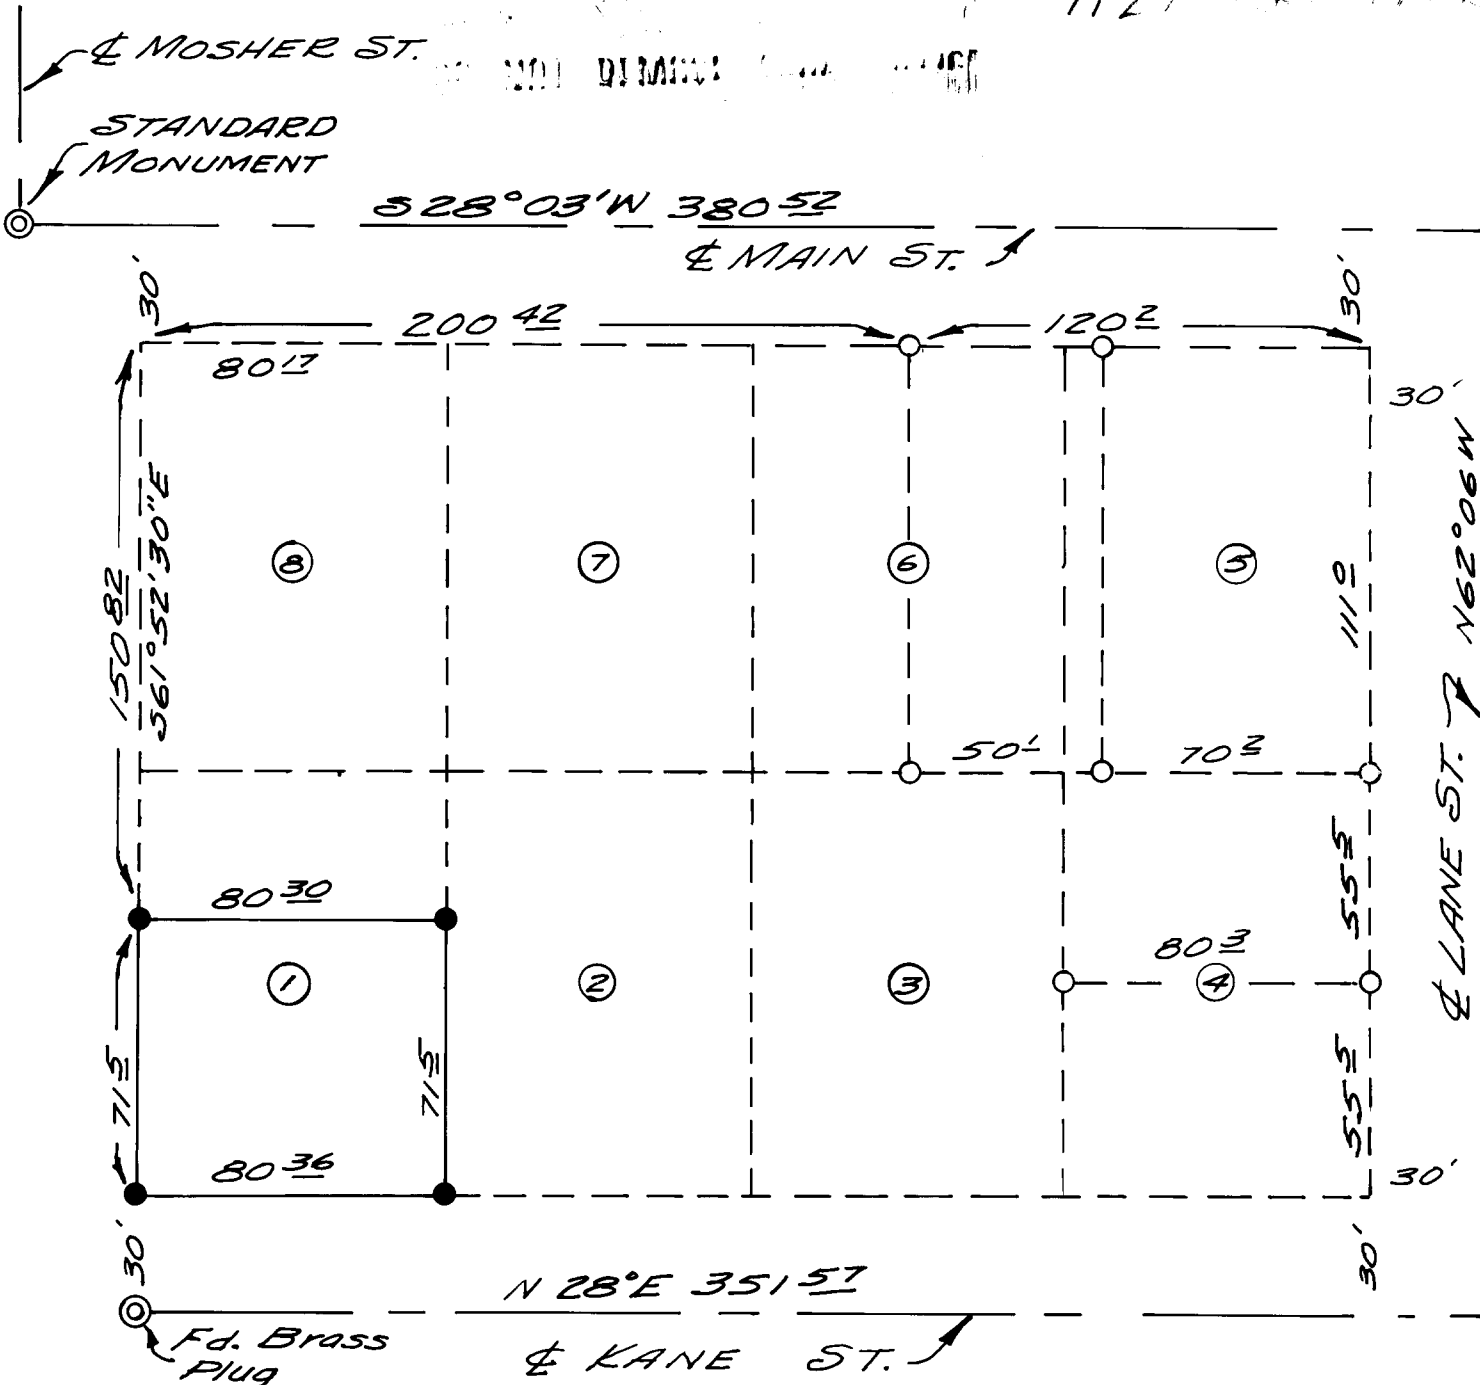

BEARINGS ARE BASED ON ORIGINAL PLAT OF ROSEBURG (N 28° E)

FOUND CORNERS ARE RECORDED IN COUNTY SURVEYOR'S FILES ~ 4-58 & 31-20

- FOUND IRON PIPE
- SET 3/4" IRON ROD

SCALE - 1 IN. = 50 FT.

SR

