

T126-12 Sec 114

LOT 9 · BL. 6 · PLAT "A" · ROSEBURG HOME ORCHARD TRACTS

John Miller
LOT 5

Surveyed For
Dell Veltri

LOT 4
EAST 660.6'

LOT 3

1/2" I.P. Fd. & Used

1/2" I.P. Set

FILED
RECEIVED

DEC - 9 1964

COUNTY SURVEYORS FILE DATA
DO NOT REMOVE FROM OFFICE

COUNTY SURVEYOR
DOUGLAS COUNTY, ORE.



DELL VELTRI

NORTH 660.6'
630.6'

630.6'
660.6'
SOUTH

LOT 8

BLOCK 6
LOT 9

LOT 10

1/2" I.P. Set
See sketch below

1/2" I.P. Set

West 660.6'

Deeded for Road Right-of-Way


CLEVELAND RAPIDS ROAD 60'

LOT 7


LOT 6
BLOCK 7

LOT 5

SCALE 1" = 100'

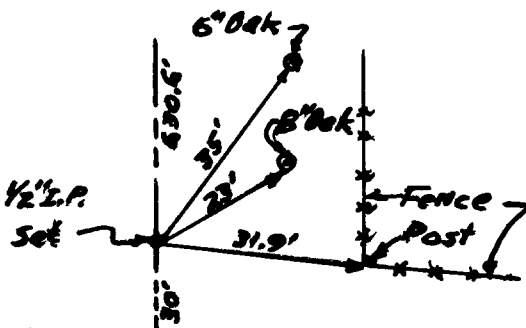

JAMES R. DAUGHERTY
CIVIL-SANITARY ENGINEER
WINSTON, OREGON

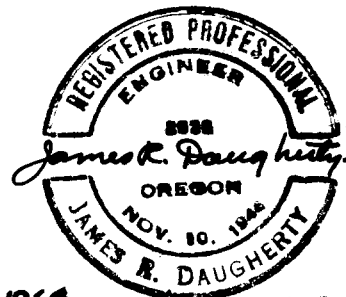

Dec. 5, 1964