


Weyerhaeuser Company

Section 14 Township 23 S Range 4 W

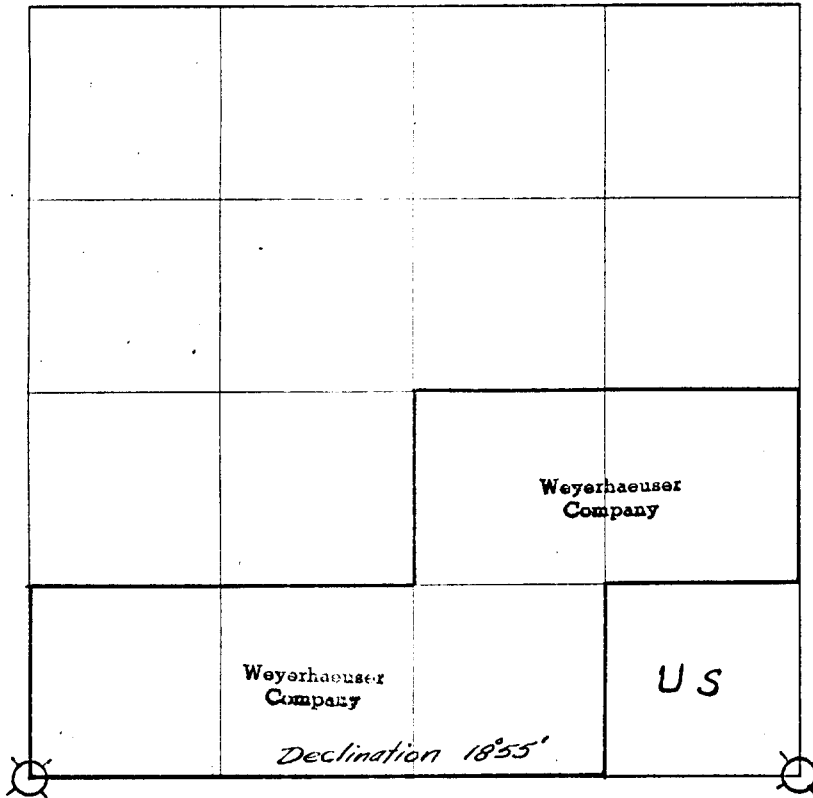

— // — // — Line marked by notch cut in blaze

- Known corner
- ⊗ Referenced corner

Staff compass survey

This survey was made for Weyerhaeuser Company by Robert Barta, under the supervision of Lester E. Calder, Oregon Licensed Engineer, Reg. No. 2149

The sale boundary marked by B L M is on the true line.

South ½ corner is lost as stated in letter from W. Haines dated August 1963

FILED
RECEIVED

Dates of survey May 15, 1964

Date filed for record & where DEC 18 1964

Distribution

COUNTY SURVEYOR
DOUGLAS COUNTY, ORE.

W.Co.-Spfld-Survey File
W.Co.-Spfld-Land Dept. File

✓ BLM - Roseburg

Reported May 18 1964

By Robert Barta