


SECTION 1, T.27S., R.6W.W.M.

COUNTY SURVEYORS FILE DATA
DO NOT REMOVE FROM OFFICE

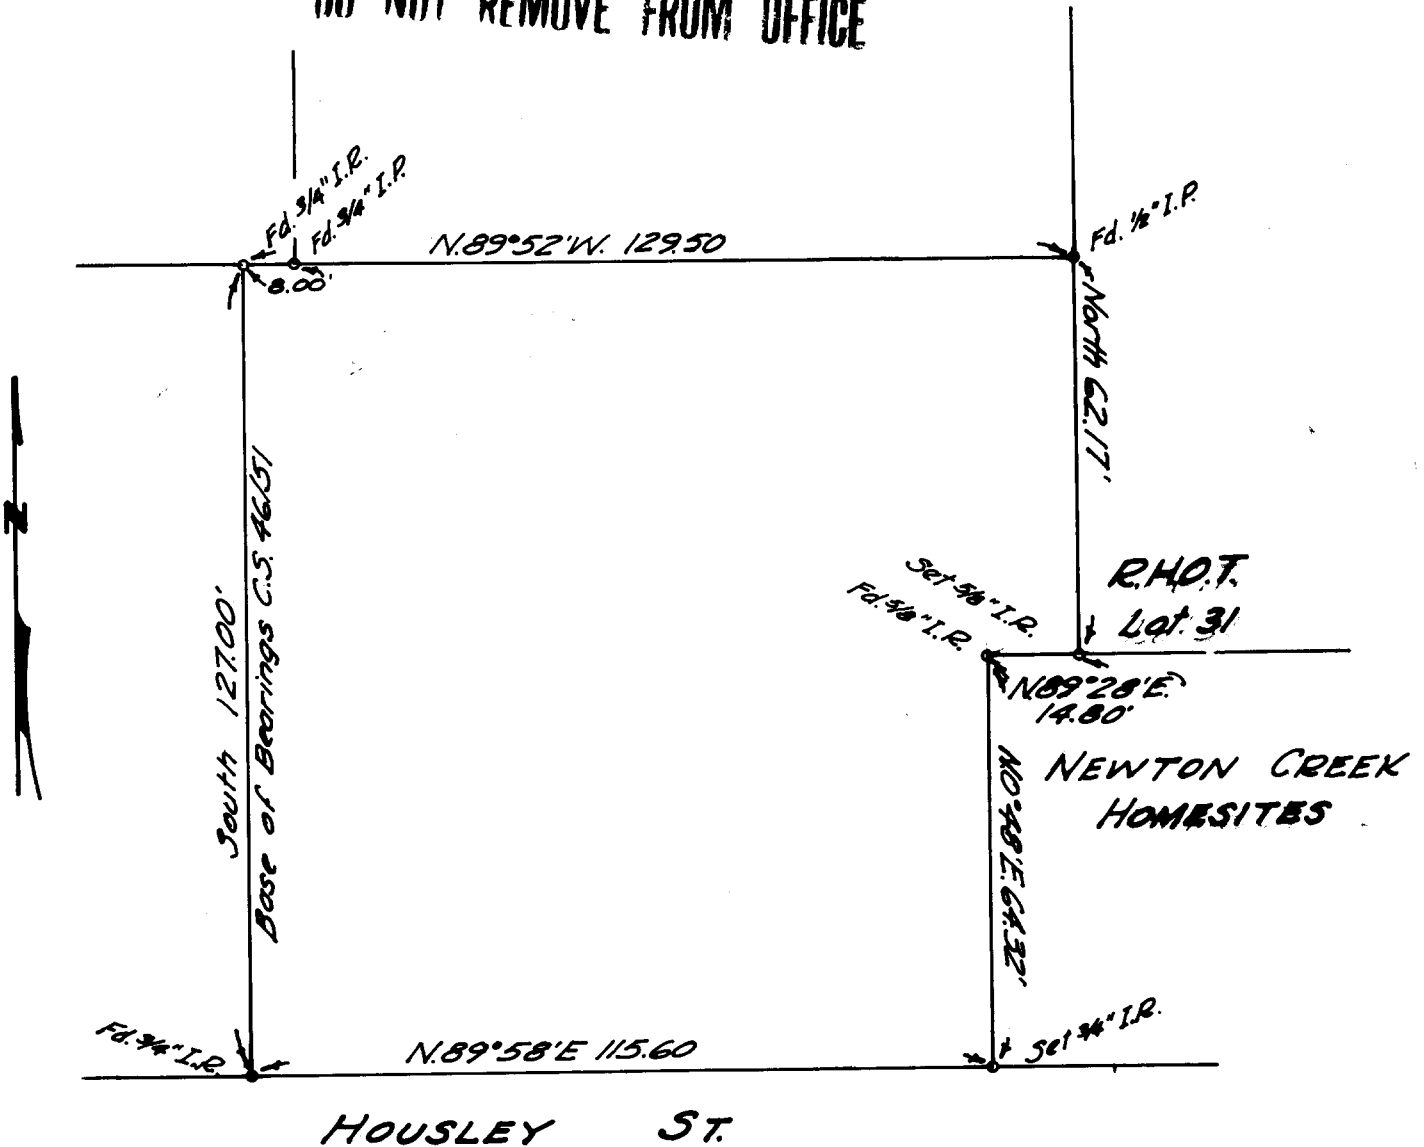

SURVEY FOR DEED DESCRIPTION
FOR LACKEY REAL ESTATE
JUNE 10, 1965 SCALE 1" = 30'

REGISTERED
OREGON
LAND SURVEYOR

Glenn S. Baughman

JULY 14, 1961
GLENN S. BAUGHMAN
536