


LOTS 11, 10, & PART OF LOT 9 - AMENDED PLAT OF FLINTS ADDITION  
BLOCK "D" T. 27-5 Sec. 19CB

RESERVOIR AVE 40'

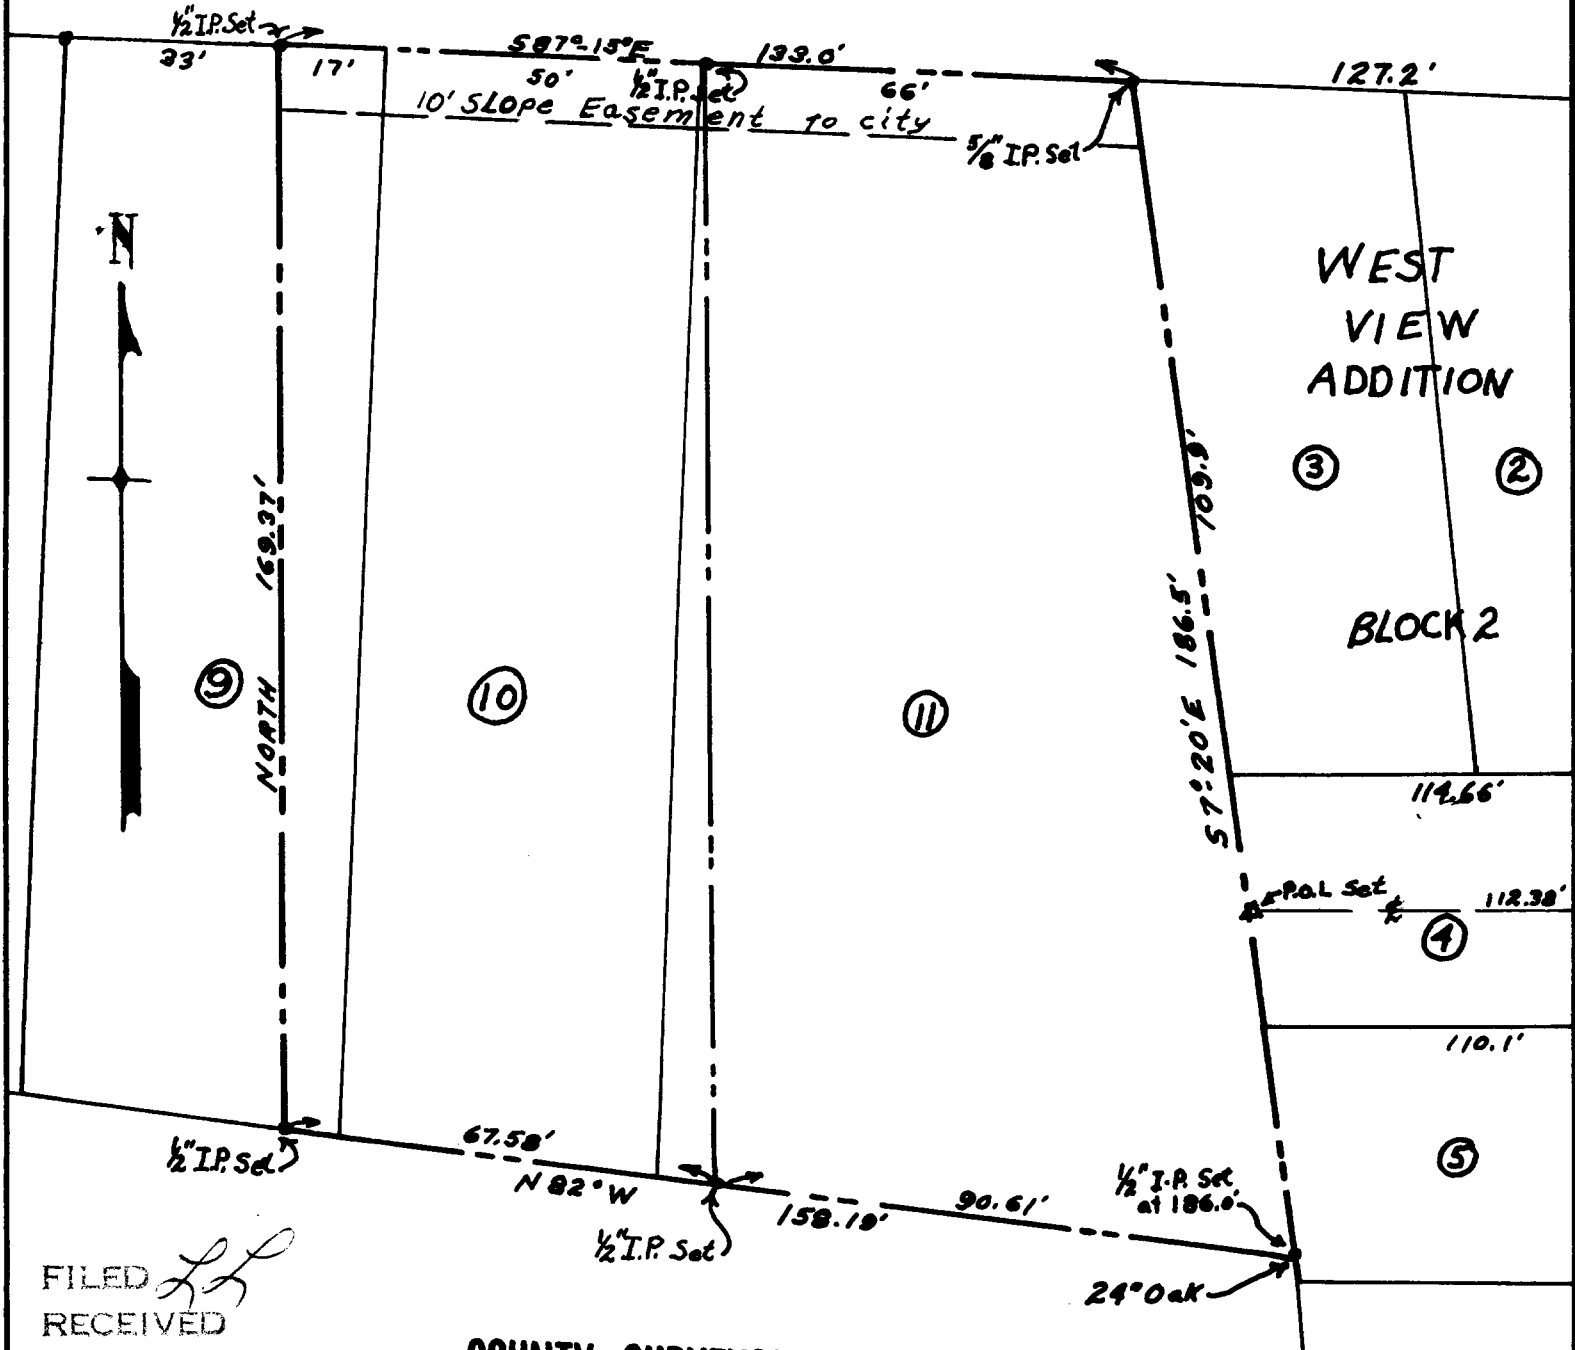

FILED *LL*  
RECEIVED  
JAN 21 1964


COUNTY SURVEYOR  
DOUGLAS COUNTY, ORE.

COUNTY SURVEYORS FILE DATA  
DO NOT REMOVE FROM OFFICE

SCALE 1" = 30'  
JAN. 9, 1965

FOR BOB HARRIS

JAMES R. DAUGHERTY  
CIVIL-SANITARY ENGINEER  
WINSTON, OREGON

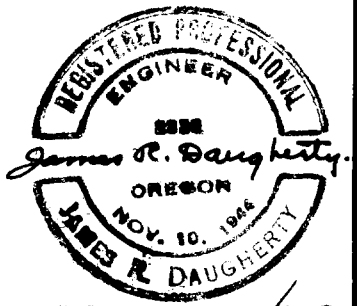

C. S. File No. 51/308-1