


Nov. 17, 1967

At  $\frac{1}{4}$  Sect. Corner Common to Sects.  
26/35 T.20 S., R.7 W. W. M.

Fd. 24" Cedar S.30° W. 15-1Ks  
" Now 48" "

Set  $\frac{5}{8}$ " x 48" Steel Rod for  $\frac{1}{4}$  Cor.

Rescribed Same 48" Cedar S.30° W. 15-1Ks  
Scribed  
48" Maple N.22° W. 42.4 Ft.

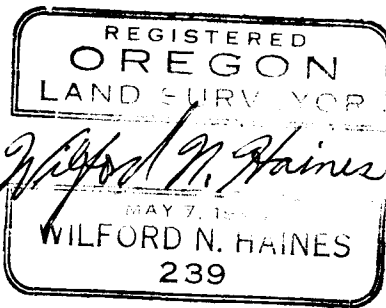

FILED *LL*  
RECEIVED

NOV 29 1967

COUNTY SURVEYOR  
DOUGLAS COUNTY, ORE.

○ #662 C. S. File No. 51/309-5