


2 1
11 12
Fd. T. IRON
3 B.T.'S

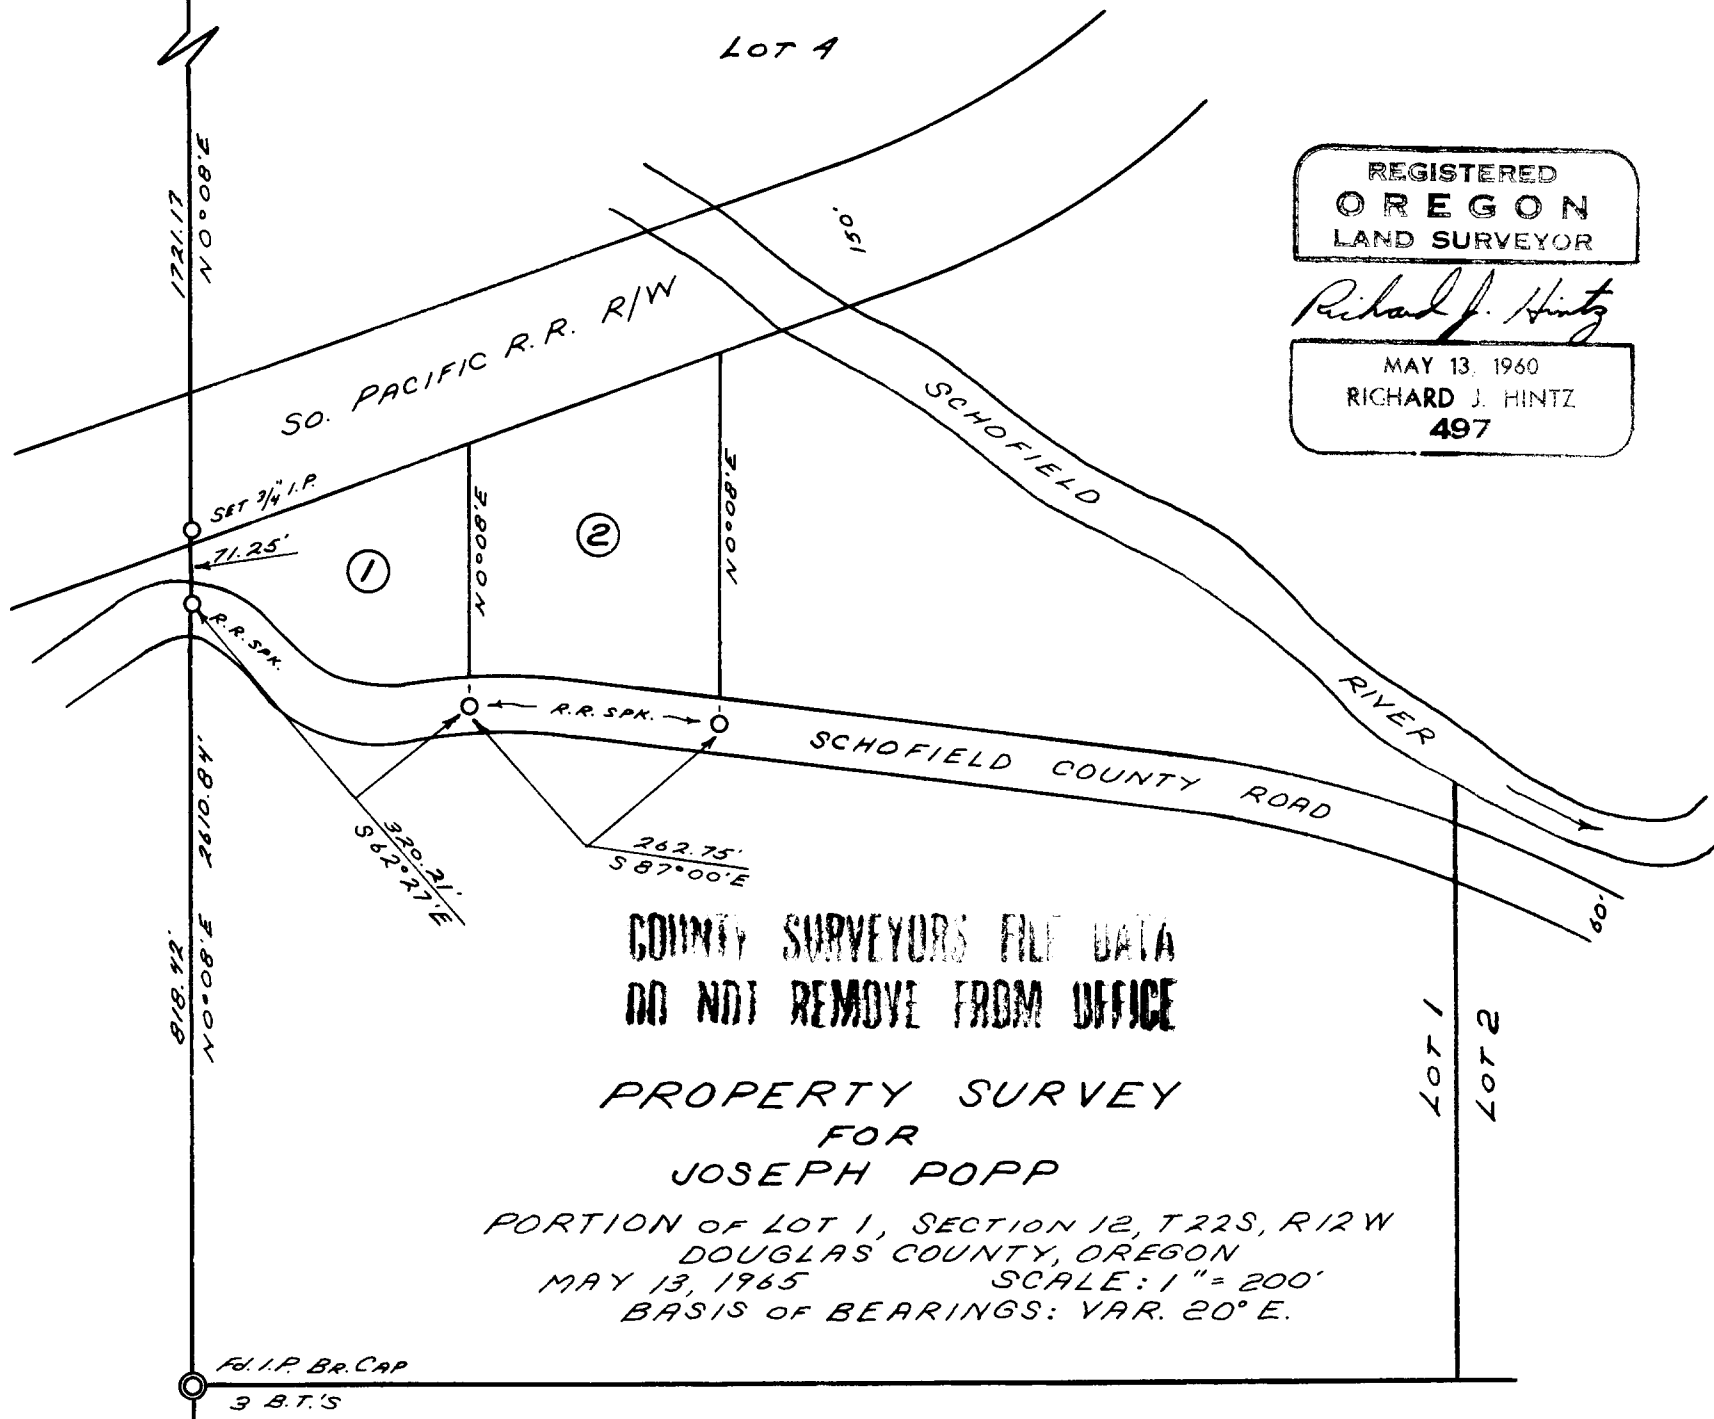

REGISTERED
OREGON
LAND SURVEYOR

Richard J. Hintz

MAY 13, 1960
RICHARD J. HINTZ
497

Richard J. Hintz
REGISTERED

MAY 25 1965

COUNTY SURVEYOR
DOUGLAS COUNTY, ORE.

COUNTY SURVEYORS FILE DATA
DO NOT REMOVE FROM OFFICE

PROPERTY SURVEY
FOR
JOSEPH POPP

PORTION OF LOT 1, SECTION 12, T22S, R12W
DOUGLAS COUNTY, OREGON
MAY 13, 1965 SCALE: 1" = 200'
BASIS OF BEARINGS: VAR. 20° E.

Fd. I.P. BR. CAP
3 B.T.'S