


COUNTY SURVEYORS FILE DATA
 TO BE REMOVED FROM ARCHIVE

PROPERTY SURVEY
 FOR
 RUDY RUPPE

LOTS 55 & 56, HIGHLANDS SUBDIVISION
 OF TRACT A, CITY OF REEDSPORT
 DOUGLAS COUNTY, OREG.
 JULY 3, 1965 SCALE: 1" = 50'

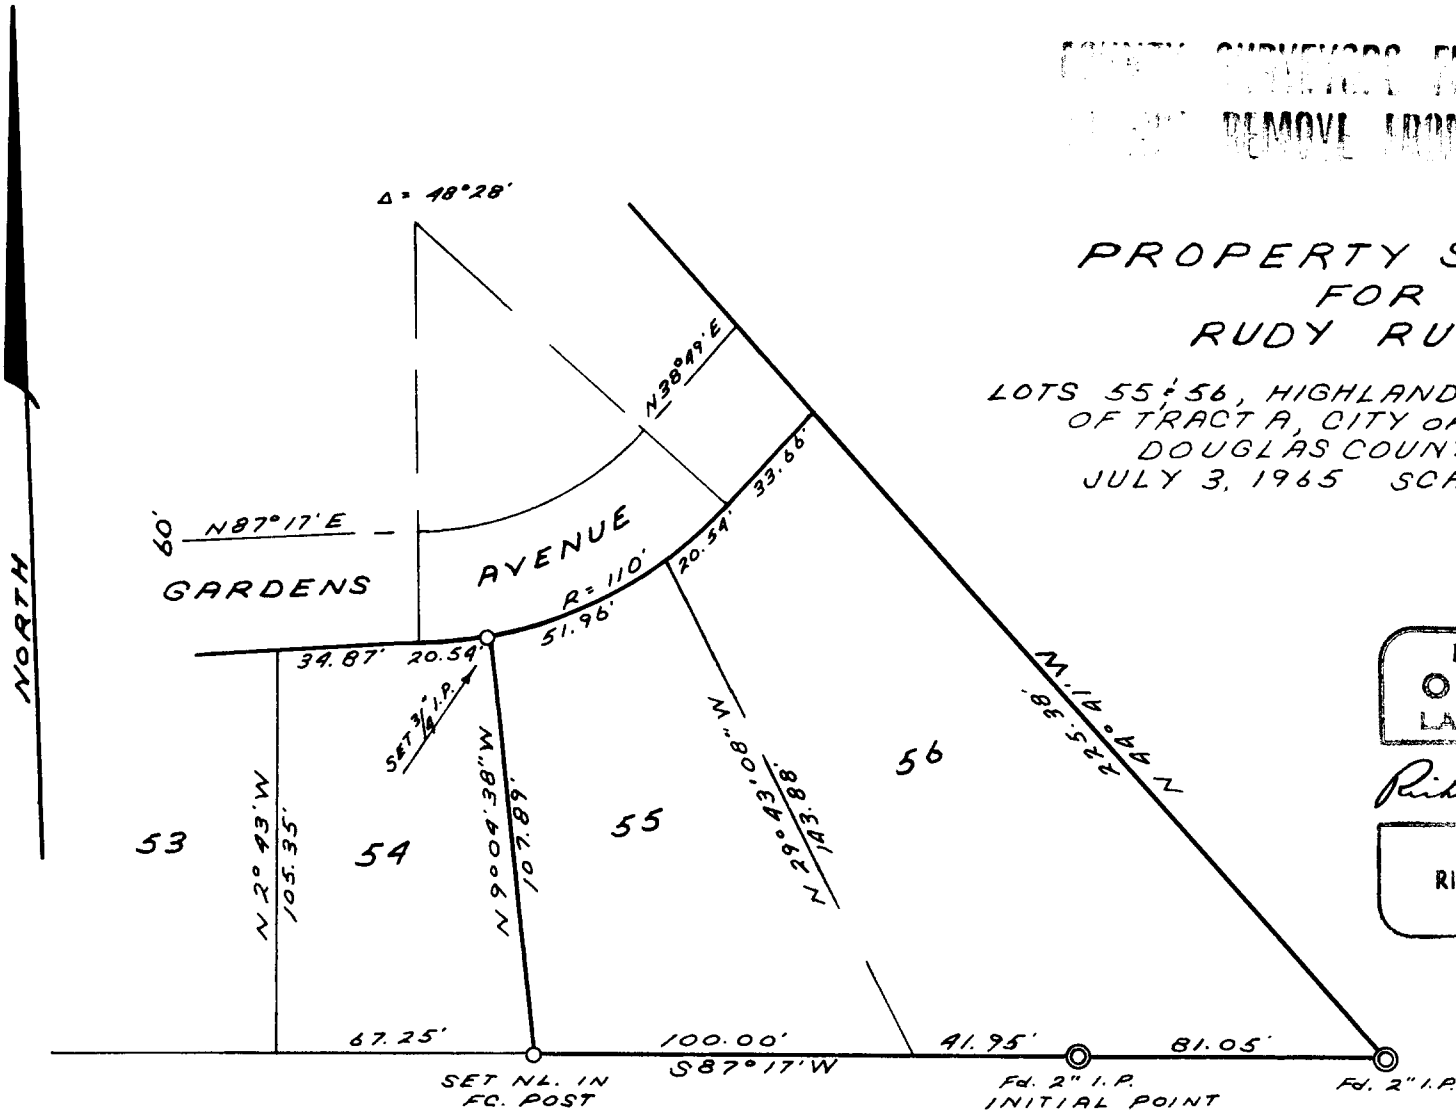

REGISTERED
 OREGON
 LAND SURVEYOR

Richard J. Hintz

MAY 13, 1960
 RICHARD J. HINTZ
 497

RECEIVED

JUL 13 1965

COUNTY SURVEYOR
 DOUGLAS COUNTY, ORE.