


COUNTY SURVEYOR'S FILE DATA  
DO NOT REMOVE FROM OFFICE

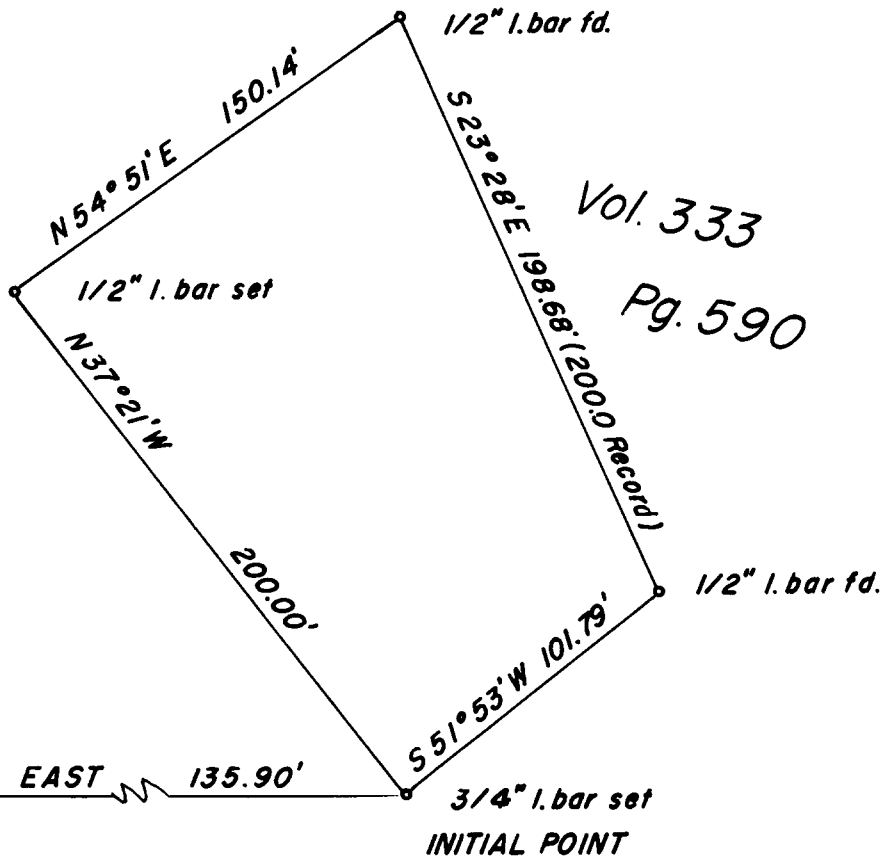

Vol. 333  
Pg. 590

SURVEY FOR SELMAR A. HUTCHINS  
LOT 17, UMPQUA PARK FRUIT LANDS  
SEC. 23, T. 27 S., R. 6 W., W. M.  
SURVEYED BY R. H. GEE  
JUNE, 1965 SCALE 1" = 60'

FILED *LF*  
RECEIVED

JUN 8 1965

COUNTY SURVEYOR  
DOUGLAS COUNTY, ORE.



S.W. COR. SEC. 23,  
T. 27 S., R. 6 W., W. M.