


SURVEY FOR PROPERTY DESCRIPTION
 IN SECS. 6 & 7 T255 R7W. W.M.
 Surveyed for Elmer Hartle June 1965
 Surveyed by Glenn S. Baughman Scale 1"=100'
 o — Denotes Set 1/2" Iron Pipe

UMPQUA R.

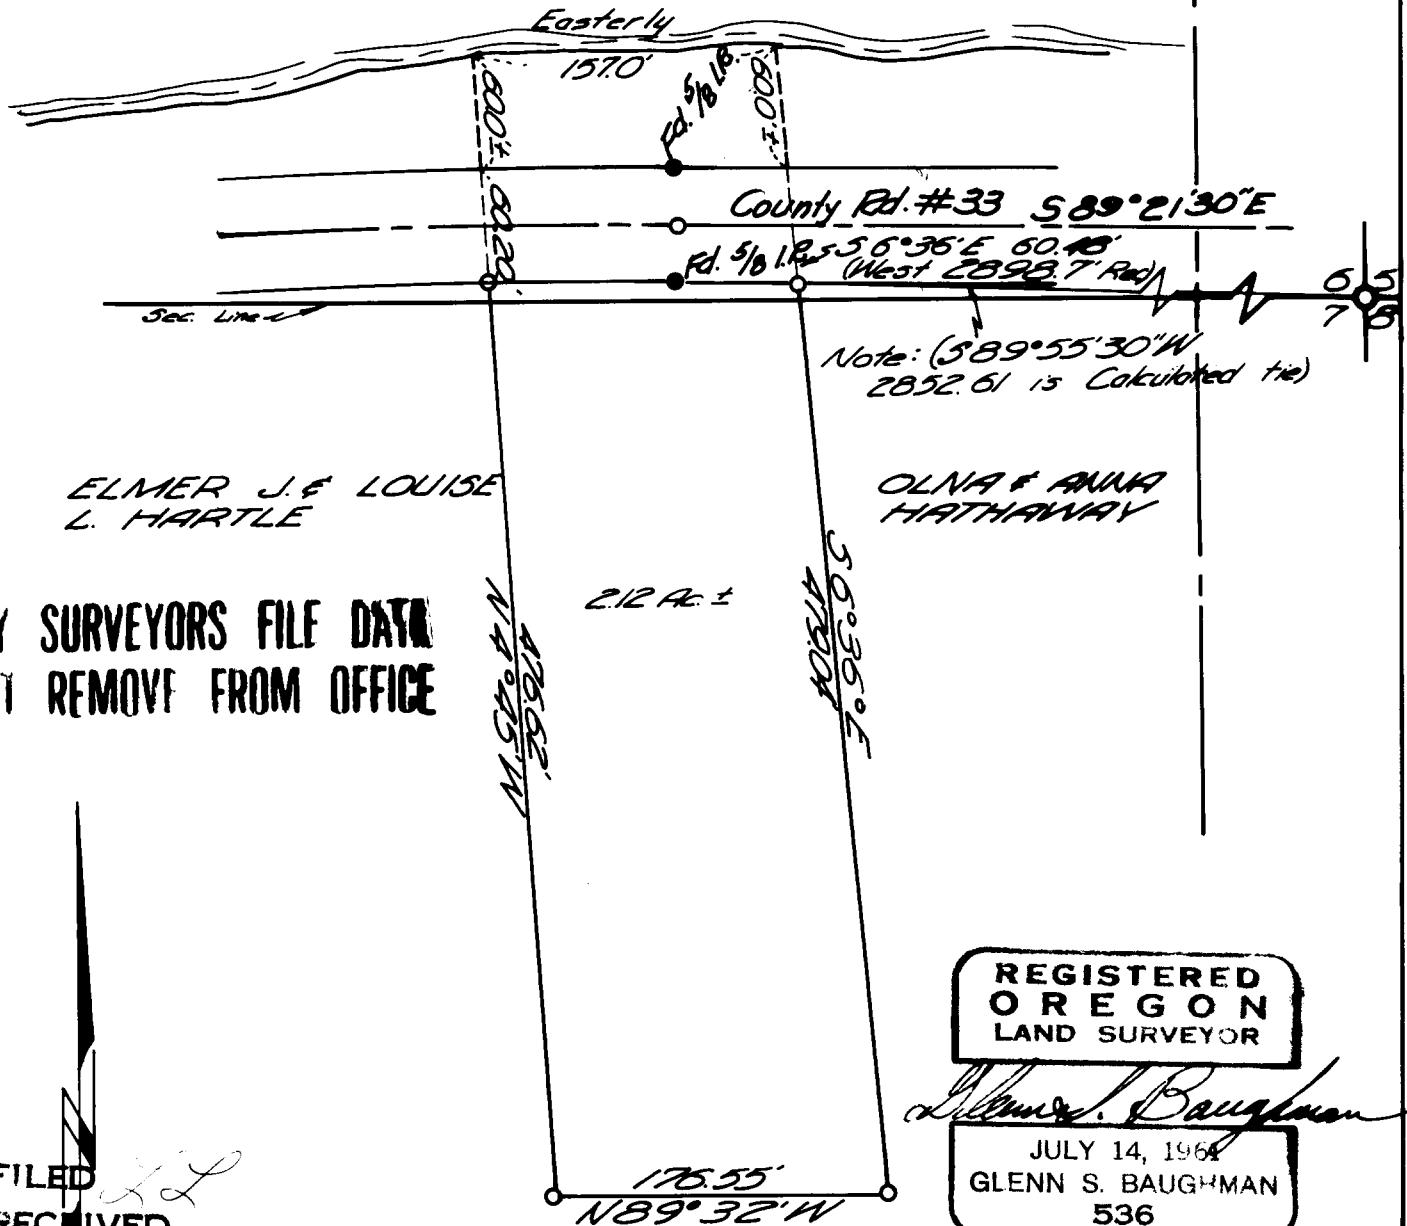

ELMER J. & LOUISE
 L. HARTLE

OLNA & ANNA
 HATHAWAY

COUNTY SURVEYORS FILE DATA
 DO NOT REMOVE FROM OFFICE

REGISTERED
 OREGON
 LAND SURVEYOR

Glenn S. Baughman

JULY 14, 1965
 GLENN S. BAUGHMAN
 536

FILED
 RECEIVED

AUG 12 1965

COUNTY SURVEYOR
 DOUGLAS COUNTY, ORE.