


**SURVEY FOR DEED DESCRIPTION
SECTION 15, T.28S., R.6W.W.M.
FOR COMMERCIAL ABSTRACT**

SCALE 1"=30'

NOV. 19, 1965

Basis for survey C.S. File 42/52 checked corner tie o.k.
I certify that I conducted this survey & the improvements
are situated as shown

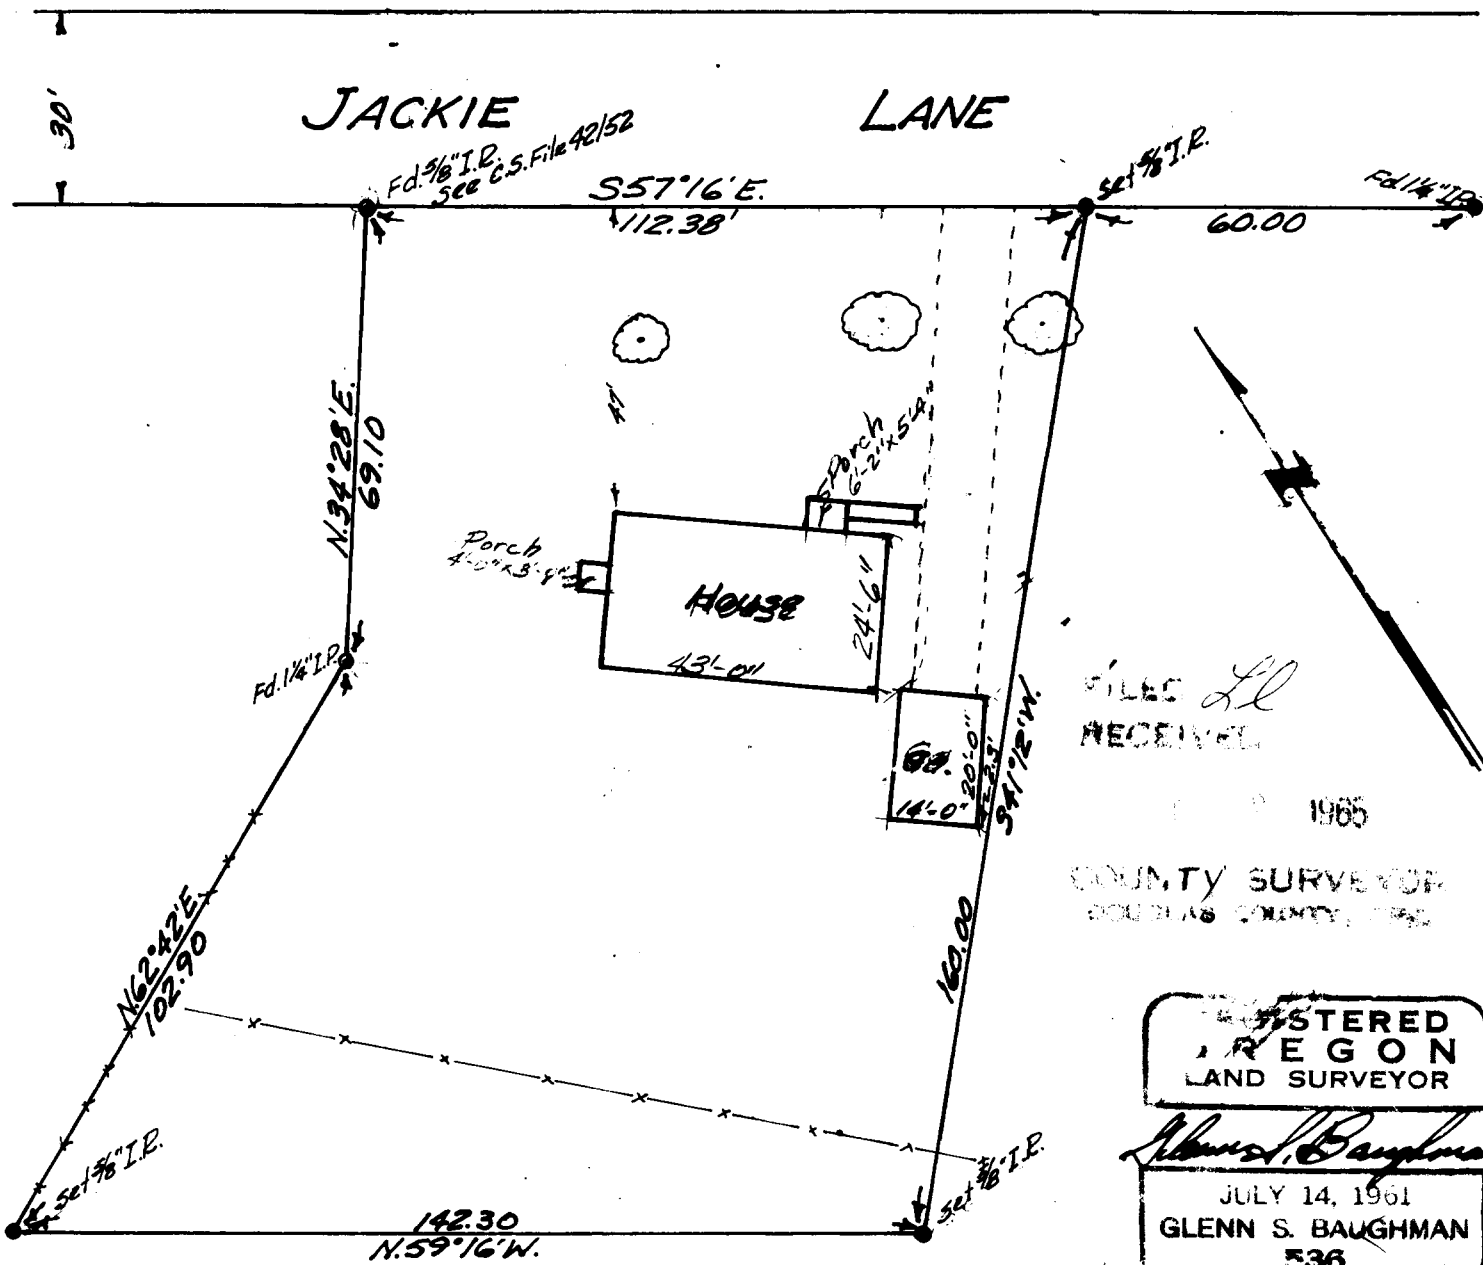

**COUNTY SURVEYORS FILE DATA
DO NOT REMOVE FROM OFFICE**