


COUNTY SURVEYORS FILE DATA
DO NOT REMOVE FROM OFFICE

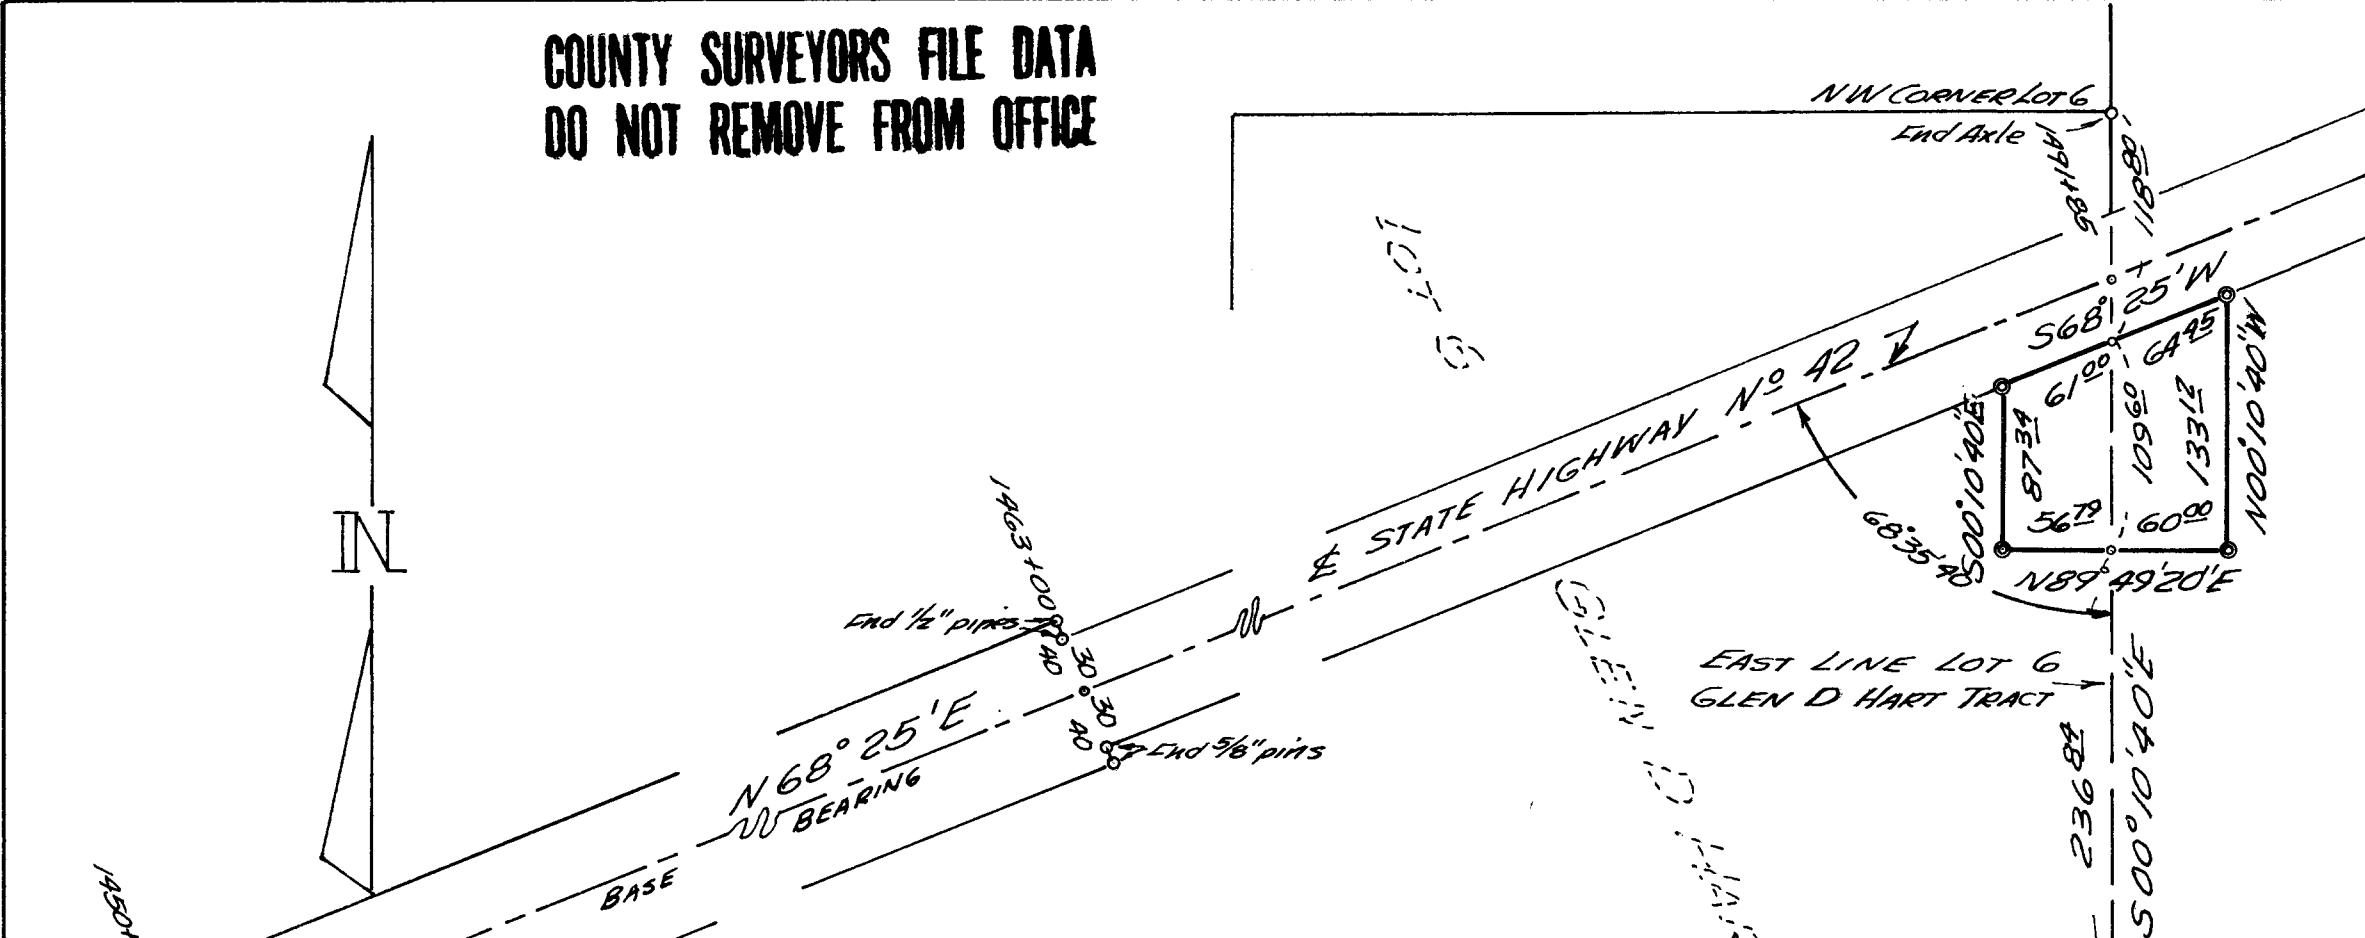

SURVEY FOR TEXACO INC
SECTION 21 T28S, R6W, W.M.
WINSTON, OREGON

EIMSTAD & ASSOCIATES
1717 WASHINGTON, EUGENE

SEPTEMBER, 1965

SCALE
1 INCH = 100 FEET

⊙ = 1 1/2" PIPE SET

REGISTERED
OREGON
LAND SURVEYOR

William A. Eimstad

MAY 4, 1956
WILLIAM A. EIMSTAD
377

FILED
RECEIVED

OCT 18 1965

COUNTY SURVEYOR
DOUGLAS COUNTY, ORE.

P. C. S. File No. 51/323