

**COUNTY SURVEYORS FILE DATA
DO NOT REMOVE FROM OFFICE**


LOT 9 BLOCK 7 GARDEN HOMES SEC. 14 T27S R6W W.M.
 Surveyed for Equitable Savings & Loan Assn.
 Surveyed by Don E. Garrett
 December 10, 1965
 Scale 1"=30'
 Bearings are based on the Northerly line of Riverview Drive N 59° 44' W

This is to certify that I have surveyed the property depicted herein and that the improvements shown do not encroach on the adjoining property.

REGISTERED
 OREGON
 LAND SURVEYOR

Don E. Garrett

JULY 14, 1961
 DON E. GARRETT
 544

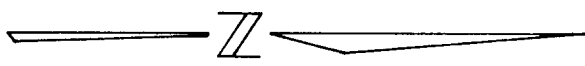


S&S Builders Survey

DL

1965

SURVEYOR
 OREGON

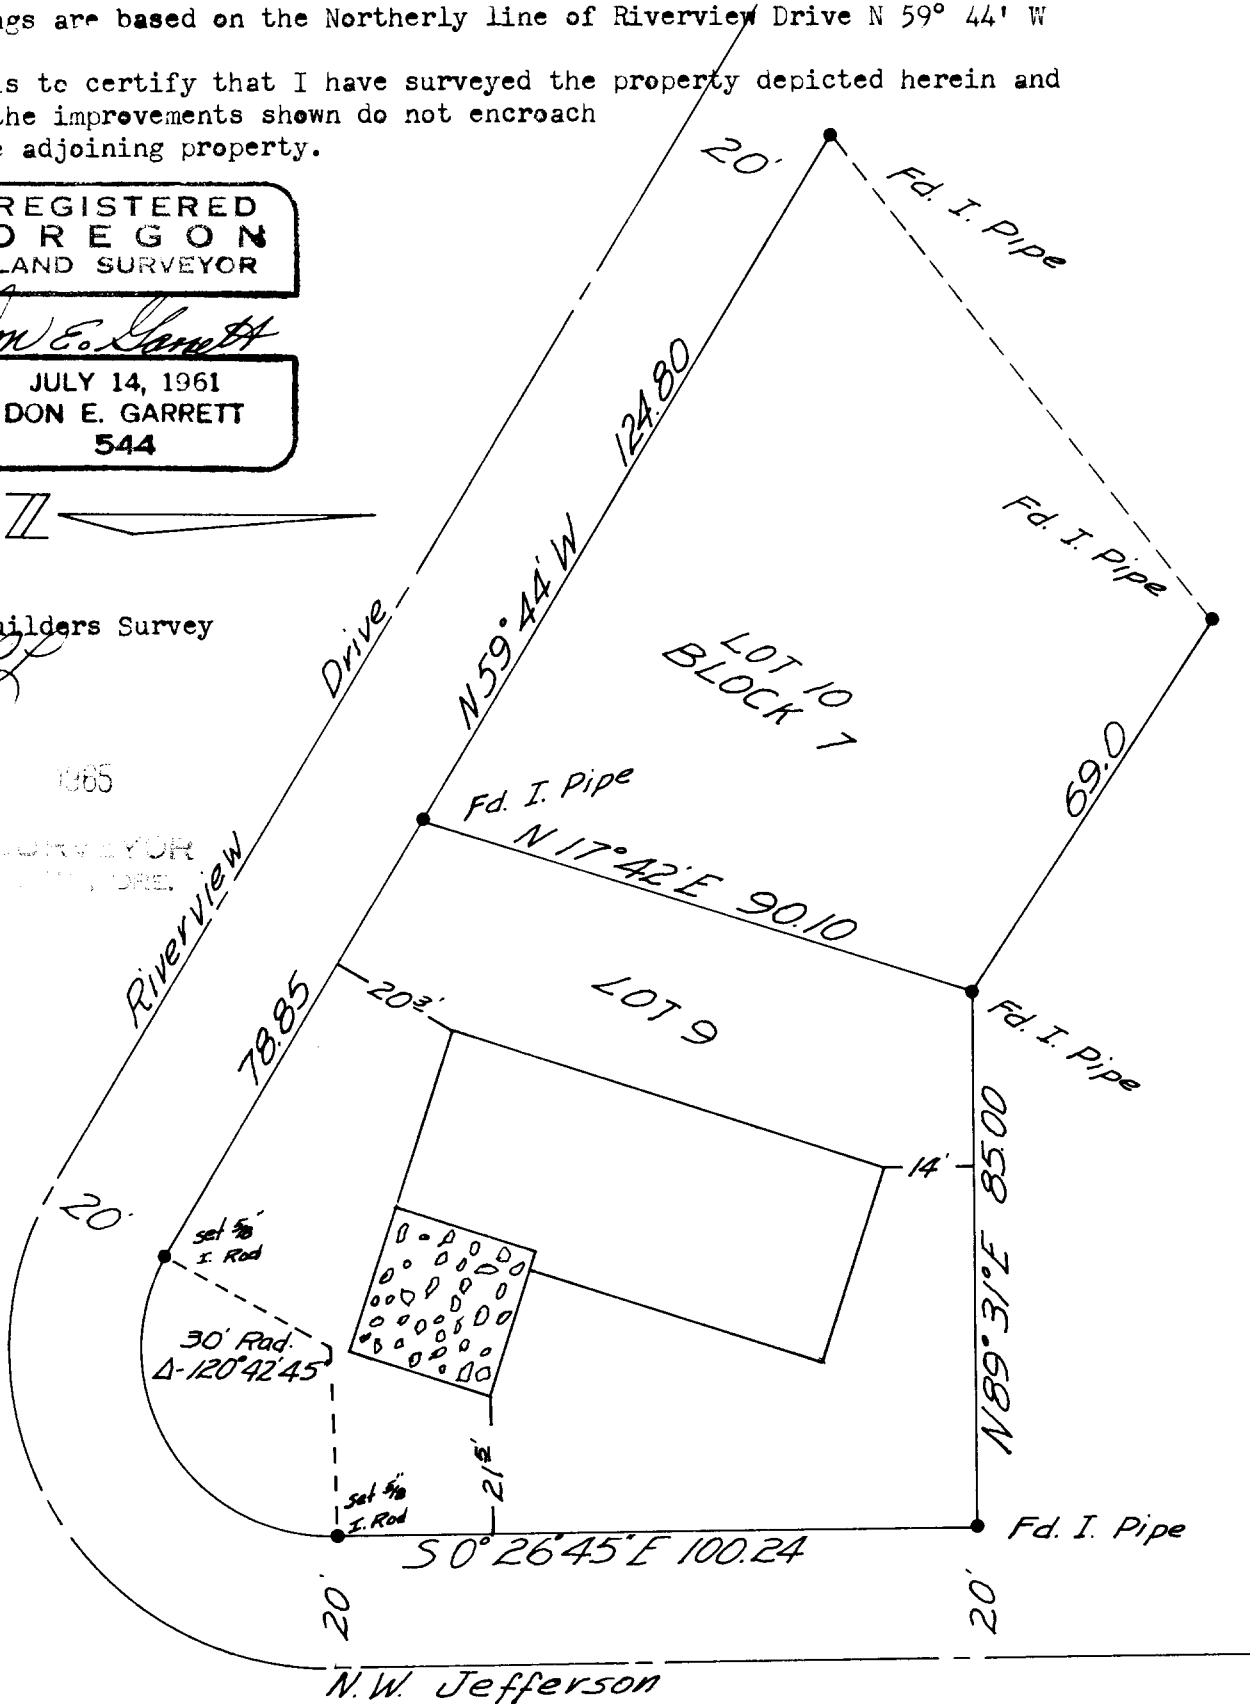

P
 51/325-3