


FILED  
RECEIVED

NOV 12 1965

COUNTY SURVEYOR  
DOUGLAS COUNTY, ORE.

COUNTY SURVEYORS FILE DATA  
DO NOT REMOVE FROM OFFICE

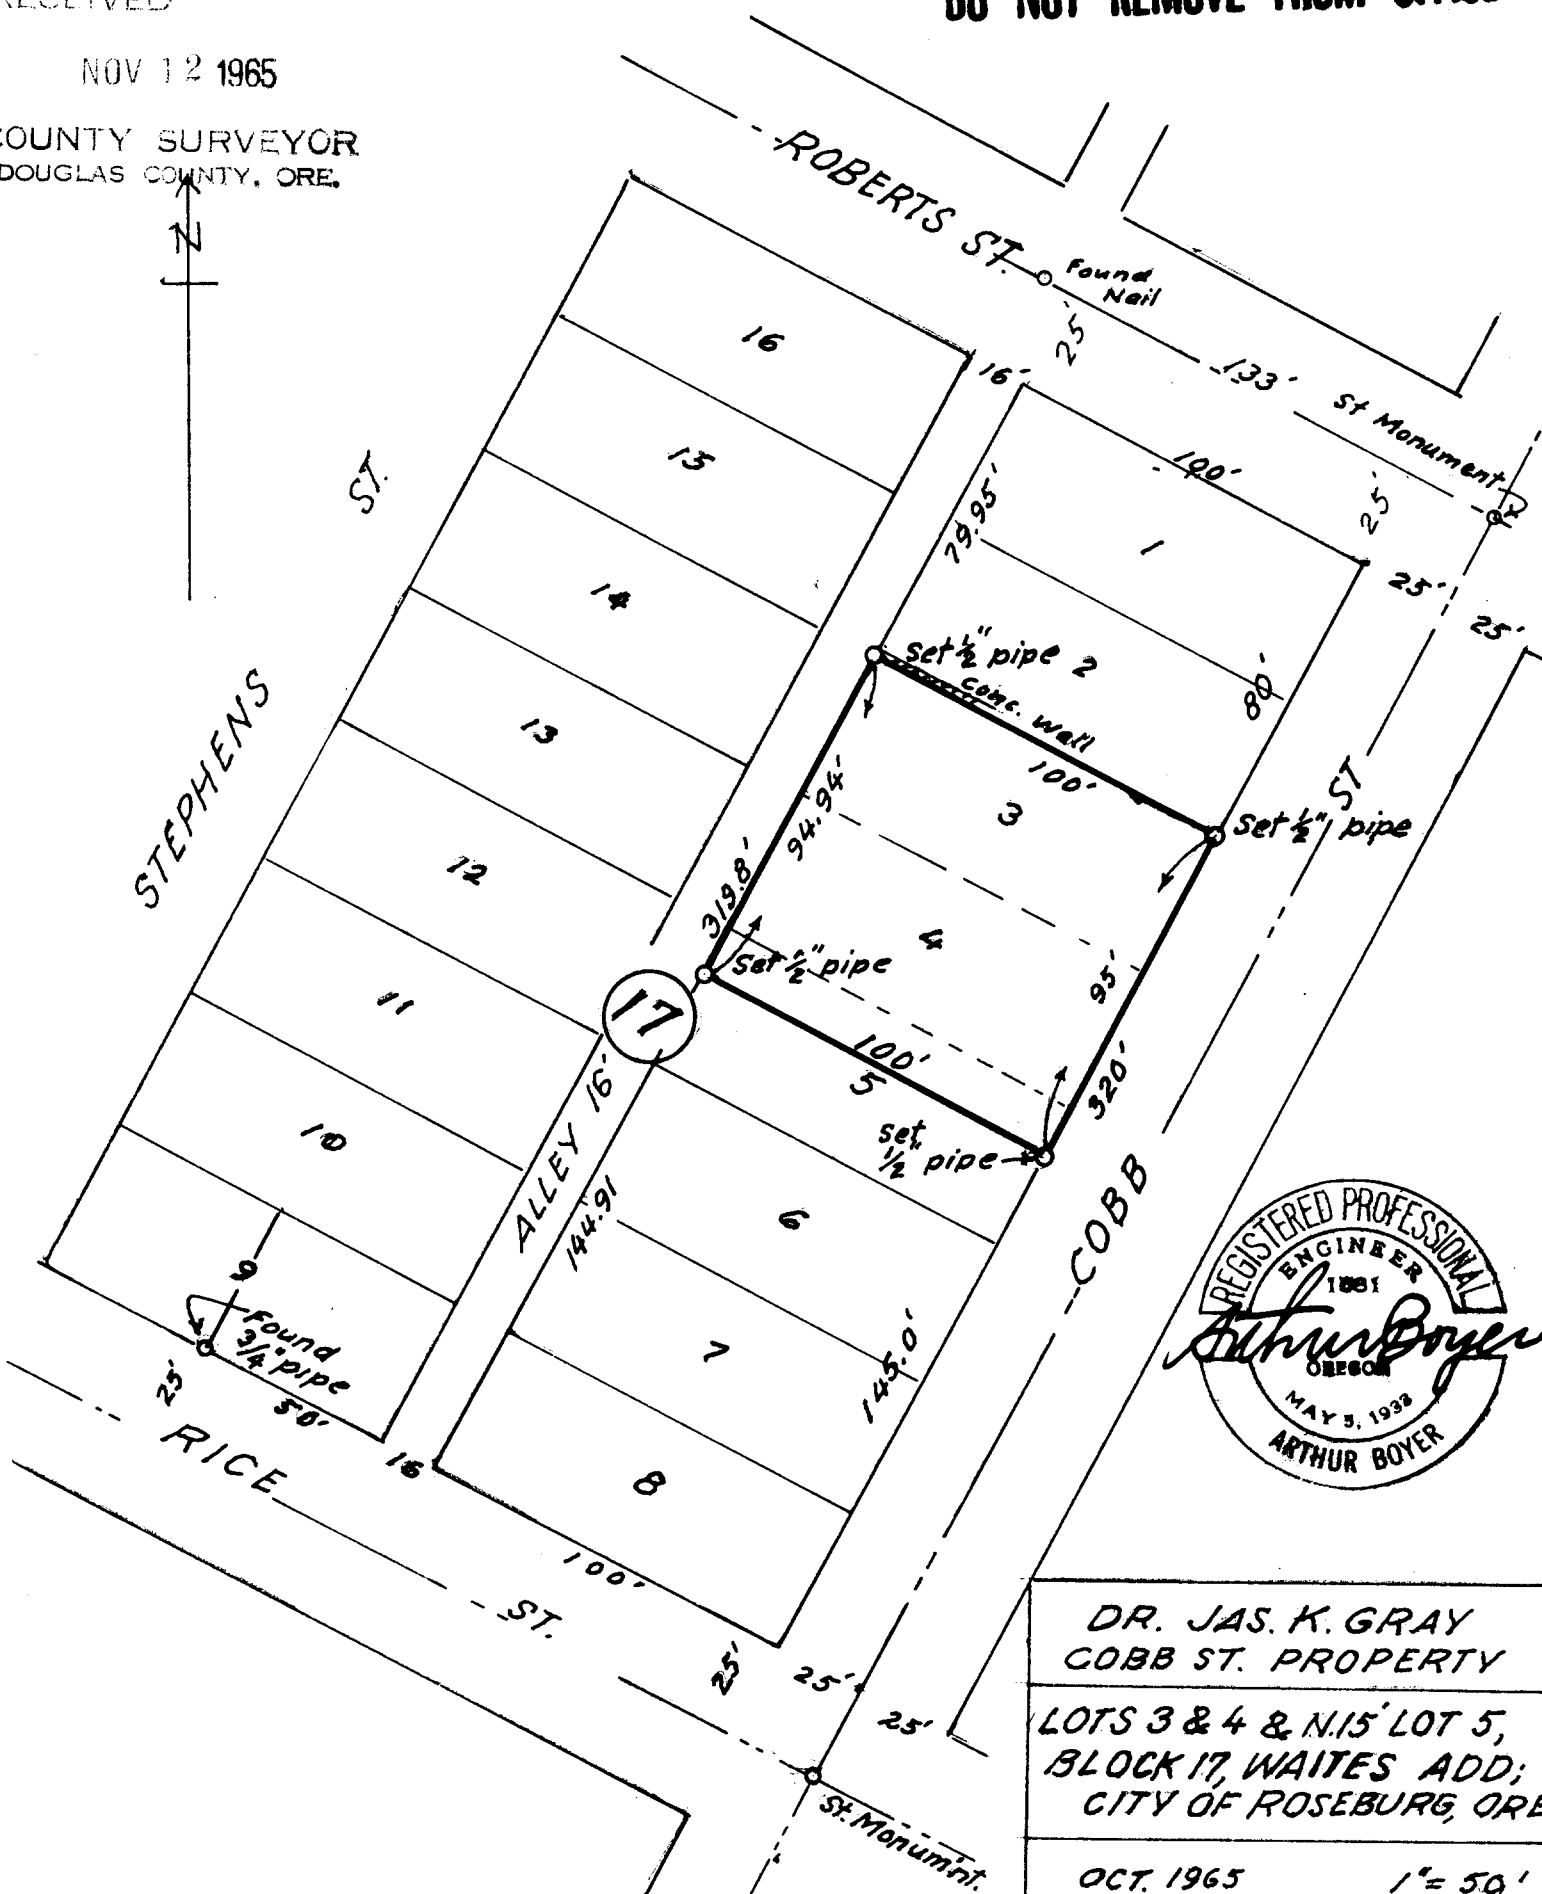

DR. JAS. K. GRAY  
COBB ST. PROPERTY

LOTS 3 & 4 & N. 15' LOT 5,  
BLOCK 17, WAITES ADD;  
CITY OF ROSEBURG, ORE

OCT. 1965 1" = 50'

D. C. S. File No. 51/326

T27-6-2400