


Brass cap

Witness Cor. to Wm. McKinney D.L.C. No. 50 S.E. Cor.  
Brass cap



T. 27 S., R. 6 W., W.M.

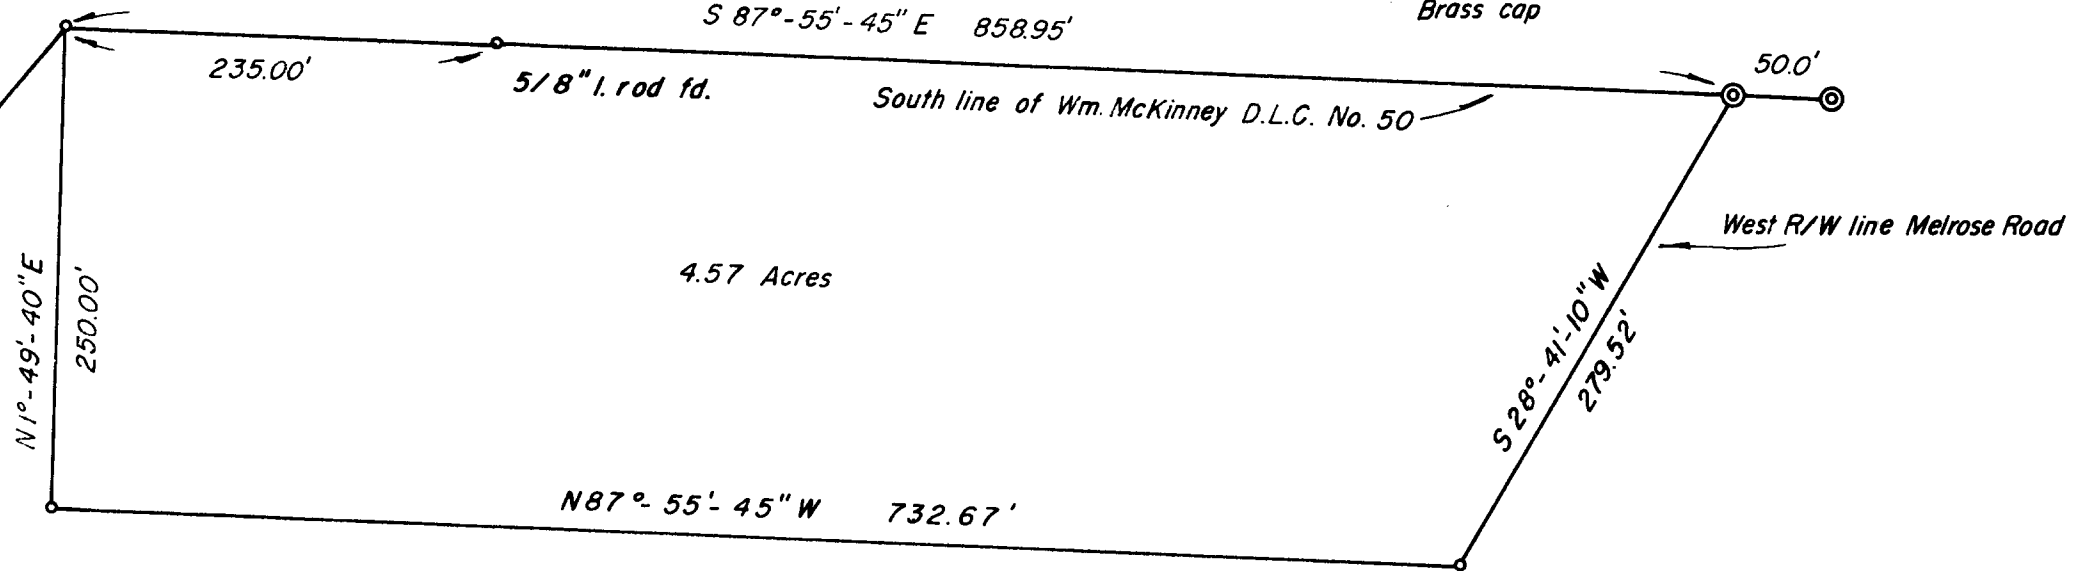

Var. 21° E

o Denotes 3/4" I.rod set

SURVEY FOR RAY GRAVES  
SECTION 16, T. 27 S., R. 6 W., W.M.  
SURVEYED BY R.H.GEE  
MARCH, 1966  
SCALE 1" = 100'

COUNTY SURVEYORS FILE DATA  
DO NOT REMOVE FROM OFFICE

