


51/329-5
P

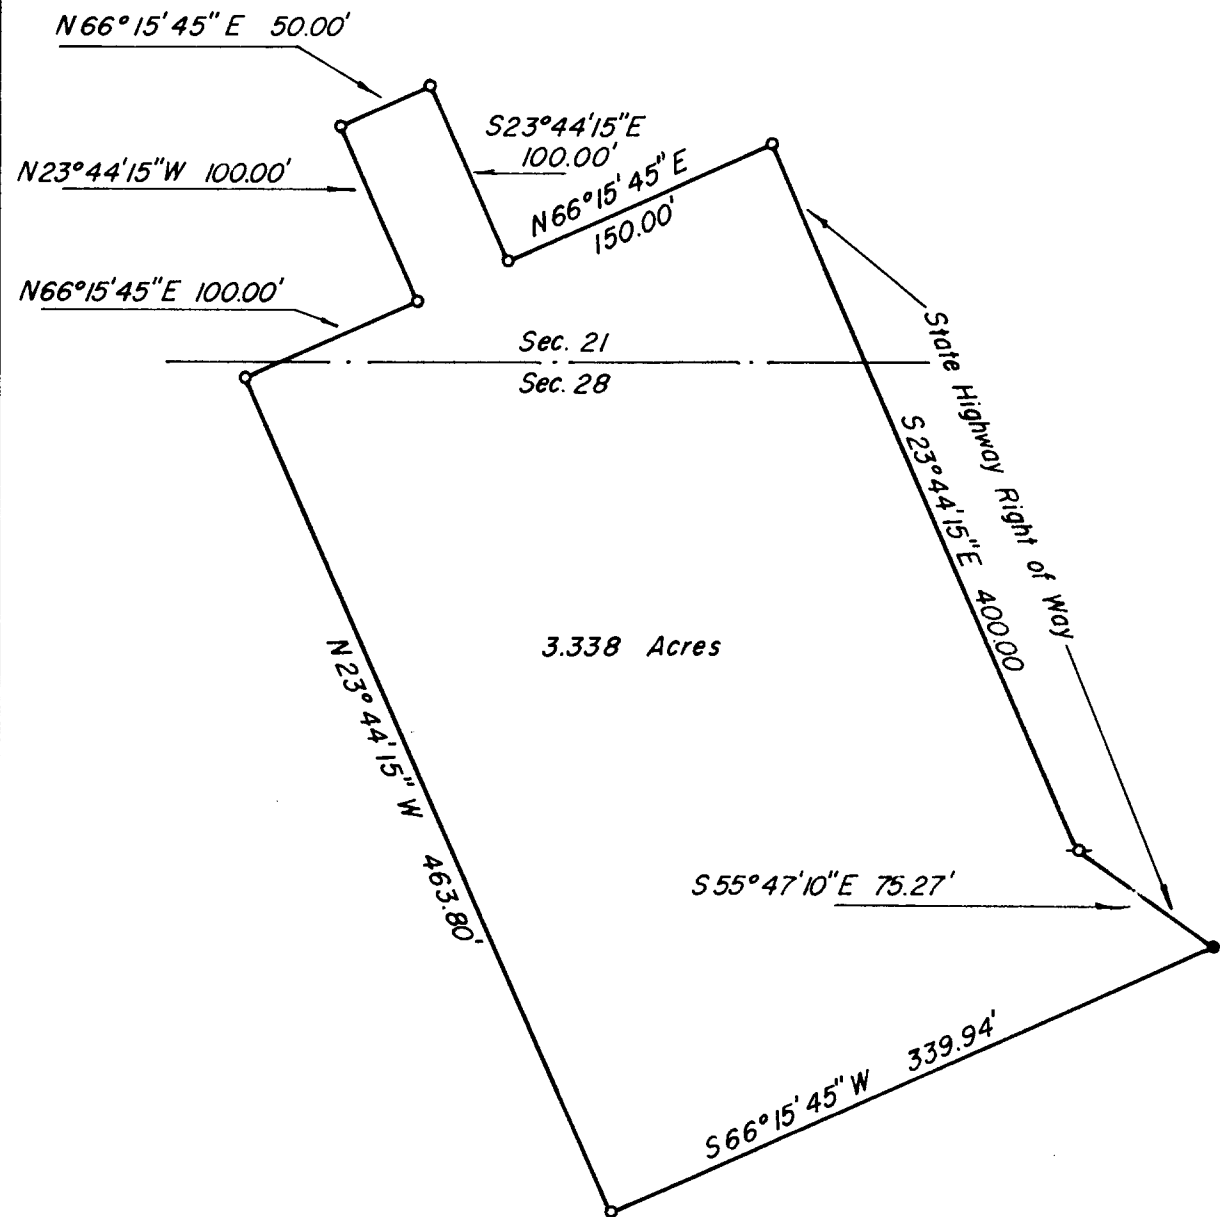

SURVEY FOR JEFFRIES TIMBER CORP.
 SECTIONS 21 AND 28, T.30S., R.5 W., W.M.
 SURVEYED BY R. H. GEE
 MARCH, 1966
 SCALE 1" = 100'

- Base bearing - Highway tangent $S39^{\circ}59' E$
- ◊ Denotes 5/8" I. rod fd.
 - Denotes 1" I. rod set
 - Denotes 3/4" I. rod set



COUNTY SURVEYORS FILE DATA
 DO NOT REMOVE FROM OFFICE