

FILED

RECEIVED

AUG 13 1963

COUNTY SURVEYOR
DOUGLAS COUNTY, ORE.

FD. O.K.

1/4 S | S
24 * 19

T 22 S R 5 8 4 9 W.

BRASS CAP & BOTH B.T.'S
MAD. IN 1931 ARE IN GOOD
CONDITION.

ROTTEN FIR SNAG BEARS
S 65° W 18 LKS. - (ORIG. B.T.)

NO TRACE LEFT OF ORIG.


N.E. B.T.

AUG. 13, 1963 T

M.G.
V.T.
M.S.

Walter E. Claffey

COR. LIES 15 OR 20 FT. SOUTH
OF LOGGING ROAD IN GOOD CONDITION

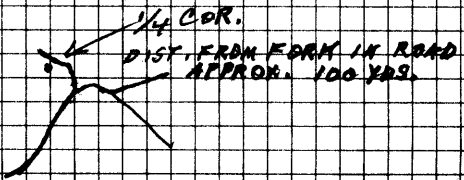

DIETZGEN NO. 385-6

CS 52/14 - 80