

REN

T 21 & 22 S R7W

S35 | S36

S2 | S1

AT COR. FD. HAINES "T"

IRON & CAP.

FD. FIR STUMP (NOW 52" DIAM.)

S36°W 20' FT. (INSTEAD OF 21' FT.)

SCRIBING VISIBLE ON OLD FACE. STUMP  
IN GOOD CONDITION.

FD. MAPLE TREE (24" DIAM.) S 15° E

132 FT. SCRIBING VISIBLE ON OLD FACE.

NO OTHER B.T.S. FD.

BLAZE & SCRIBE :

28" RED CEDAR N34°W 52' FT.

MKD. "T21SR7WS35CSBT" - ONE BLAZE

24" DOUG. FIR N62°E 53' FT.

MKD. "T21SR7WS36CSBT" - BARK SCRIBE

NO TREES AVAILABLE IN SEC. 2.

MAY 10, 1962

M.G.

V.T.

C.P.

*Phil E. Godfrey*

+ \* ○ ✓

C. S. File No. 5214-111

Parker  
check

T 20 S R 7 W Sect. 36

1891 SURVEY

MRS. TODD

West on South Bdry.

0.50 Cross Smiths River

9.50 ascend slightly

11.00 STREAM 4-1Ks Crs. N 80° E

1/4 S

WELLER

1883

21.00 1/4 post { 24" fir N 28° E 12-1Ks = 7.92  
 south { 29" fir S 33° W 49-1Ks = 32.34  
 (Did NOT find) S 32° W

7045

45074

28.00 Top of spur NE South

30.00 Canyon Crs S 10° E

40.00 post { 8" maple S 34° E 26-1Ks = 17.16  
 1/4 Cr 36 { 28" fir N 12° W 20-1Ks = 13.2 ft.  
 Set T. iron ← Fd. stump

45.00 Stop of spur NE.

53.50 Canyon NE

Fd stump describe

COR SECS  
21

WELLER

1883

61.30 post { 10" fir N 65° E 26-1Ks 17.16  
 sect 142 { 16" fir S 63° W 12-1Ks Nat. Fl. 7.92  
 Set T. iron { 16" fir S 65° E 42-1Ks 27.72

About 50 ft West of spur Fd

67.25 Canyon

76.00

(Looks o.k.)

80.00

post ~~...~~ (Set T iron)

Re-scribed  
17 BACK

30" Fir

9" Fir

8" Fir

N 10° E

N 10° E

S 10° E

45-115 = 29.70 N 10° E 48" ±

58-115 = 34.28 N 10° E

38-115 = 25.08 N 10° E

Scribed 28" D Fir N 32° W 68.2 Ft

There is a 30" Fir S 36° E (50 Ft ±)

that look like B.T.

FD, 60" FIR N 6° W 29" SCRIBED IN WOOD "S"


NEW BARK SCRIBE "T 20 S R 7 W S 36 BT" (HAINES METAL DISC ON BARK)

28" FIR N 32° W 68.2" NEW SCRIBE "T 20 S R 7 W

S 36 BT"

MK. 17 "MADRONE N 50° E 51 3/4" "T 20 S R 7 W S 36 CS BT"

ON SPUR N 35° W

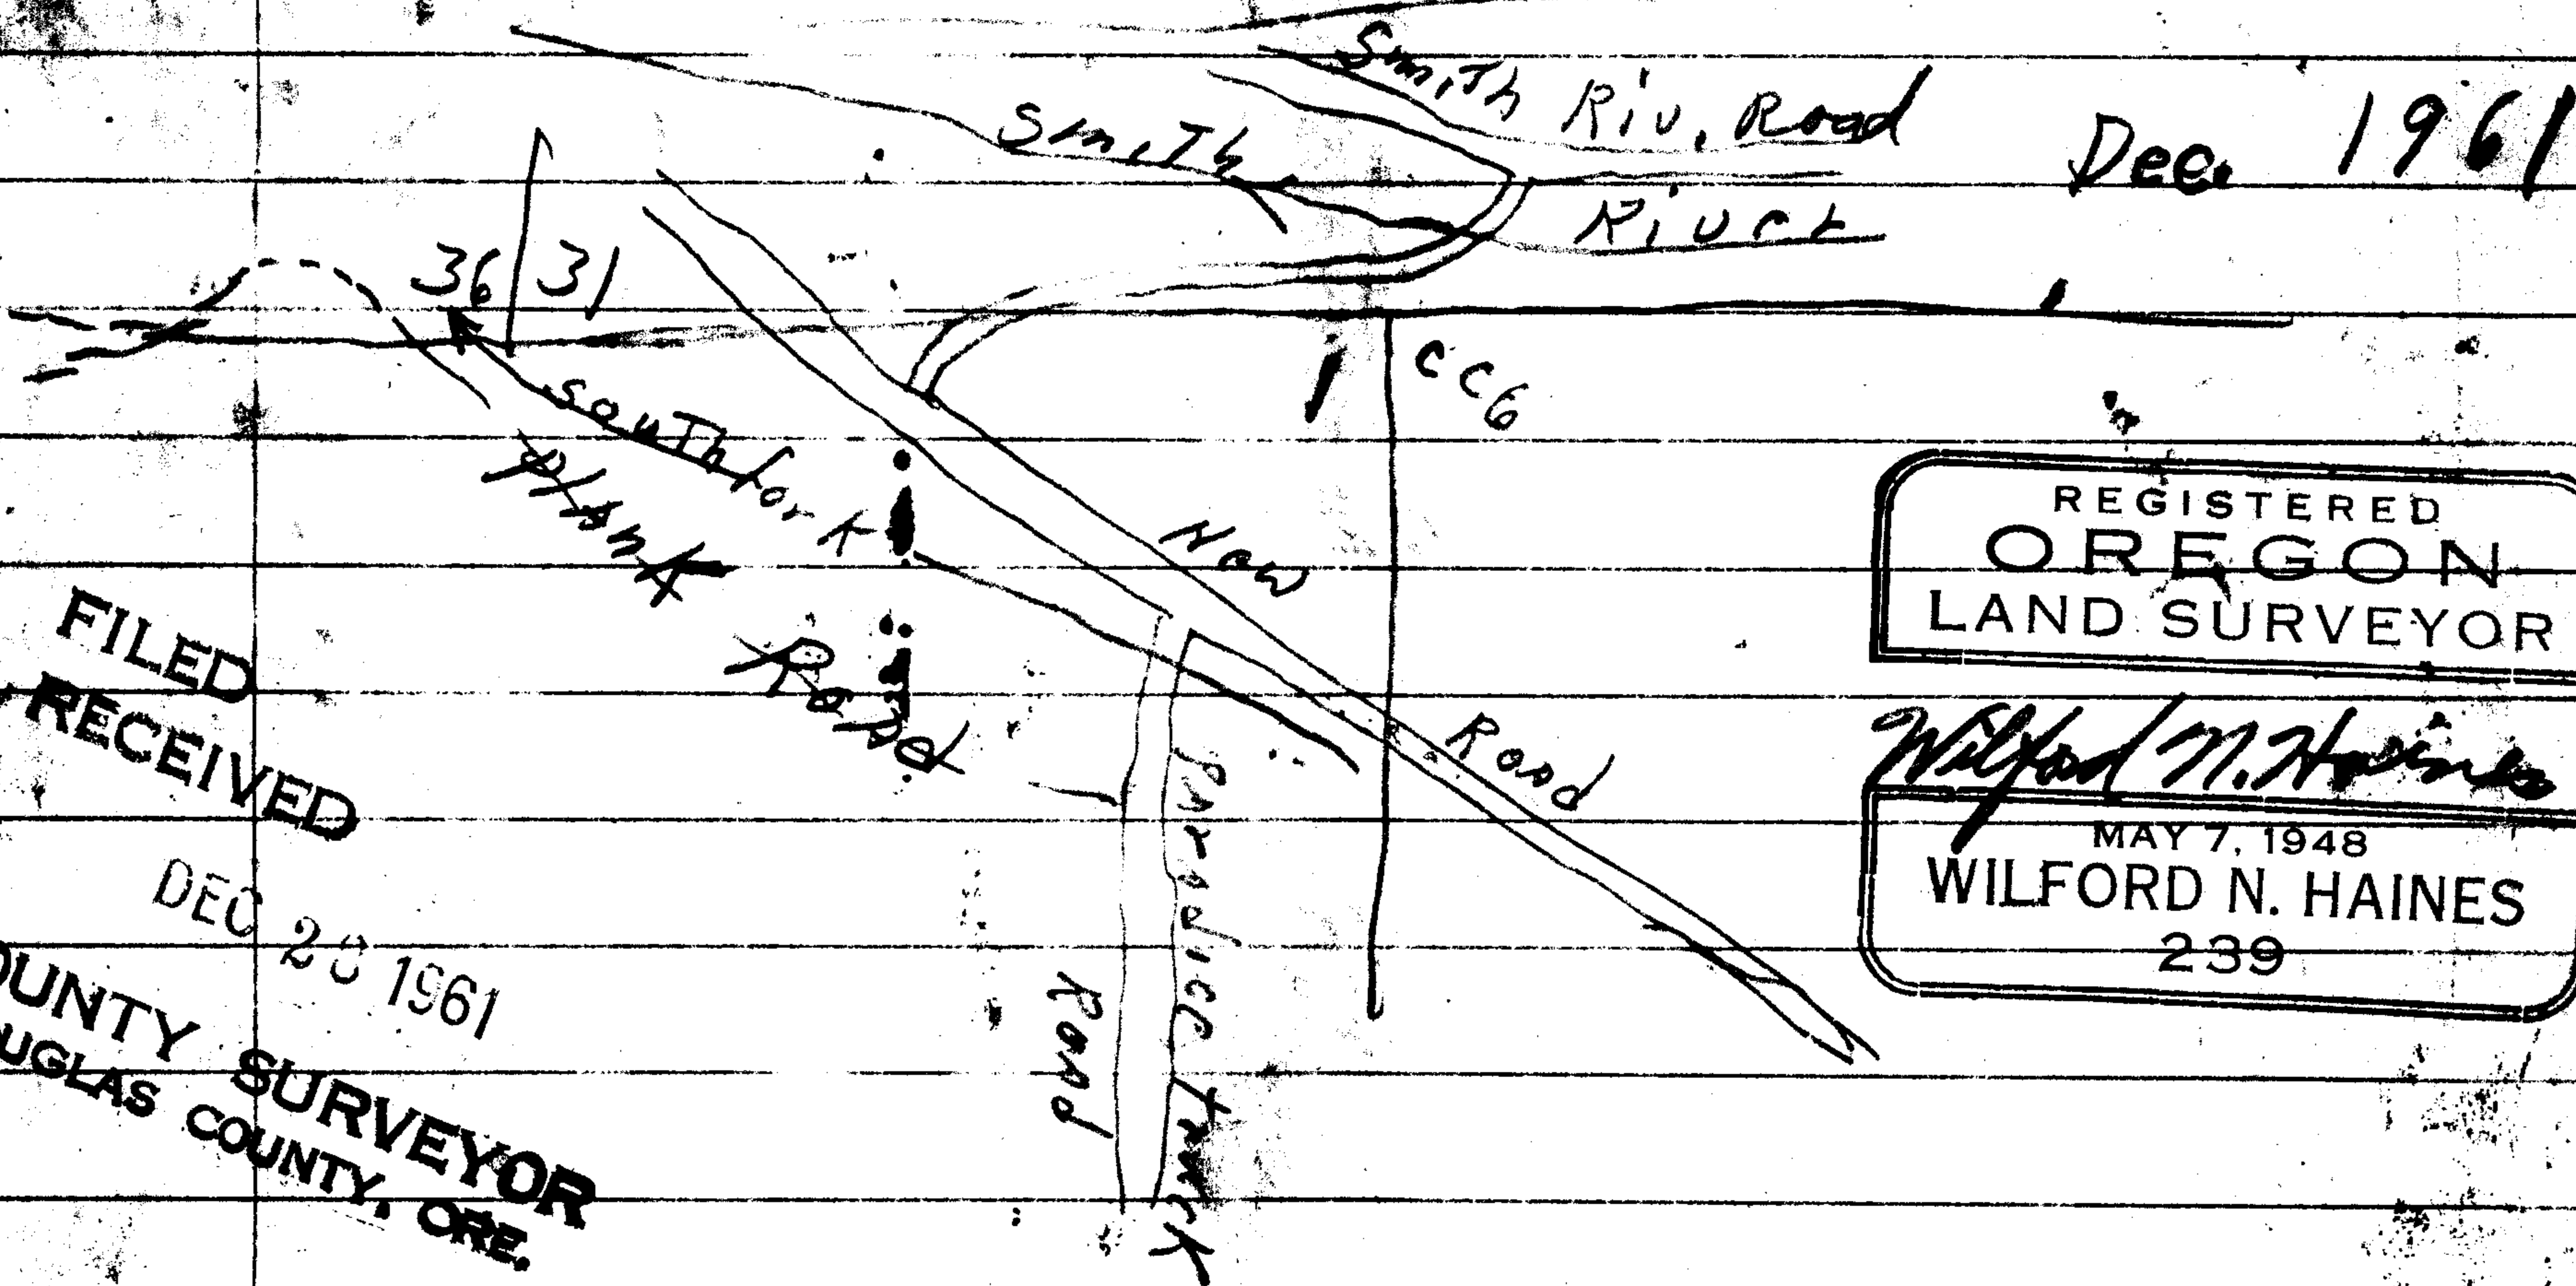

REGISTERED  
OREGON  
LAND SURVEYOR

Wilford N. Haines  
MAY 7, 1948  
WILFORD N. HAINES  
239

FILED  
RECEIVED

DEC 20 1961

COUNTY SURVEYOR  
DOUGLAS COUNTY, ORE.

No. 52/12