


M. Godfrey
V. Tracy
C. Putnam

TWP 22 S., RGE 7 W., W.M.

(NOT FOUND in two searches) T 215 - R 7 W only

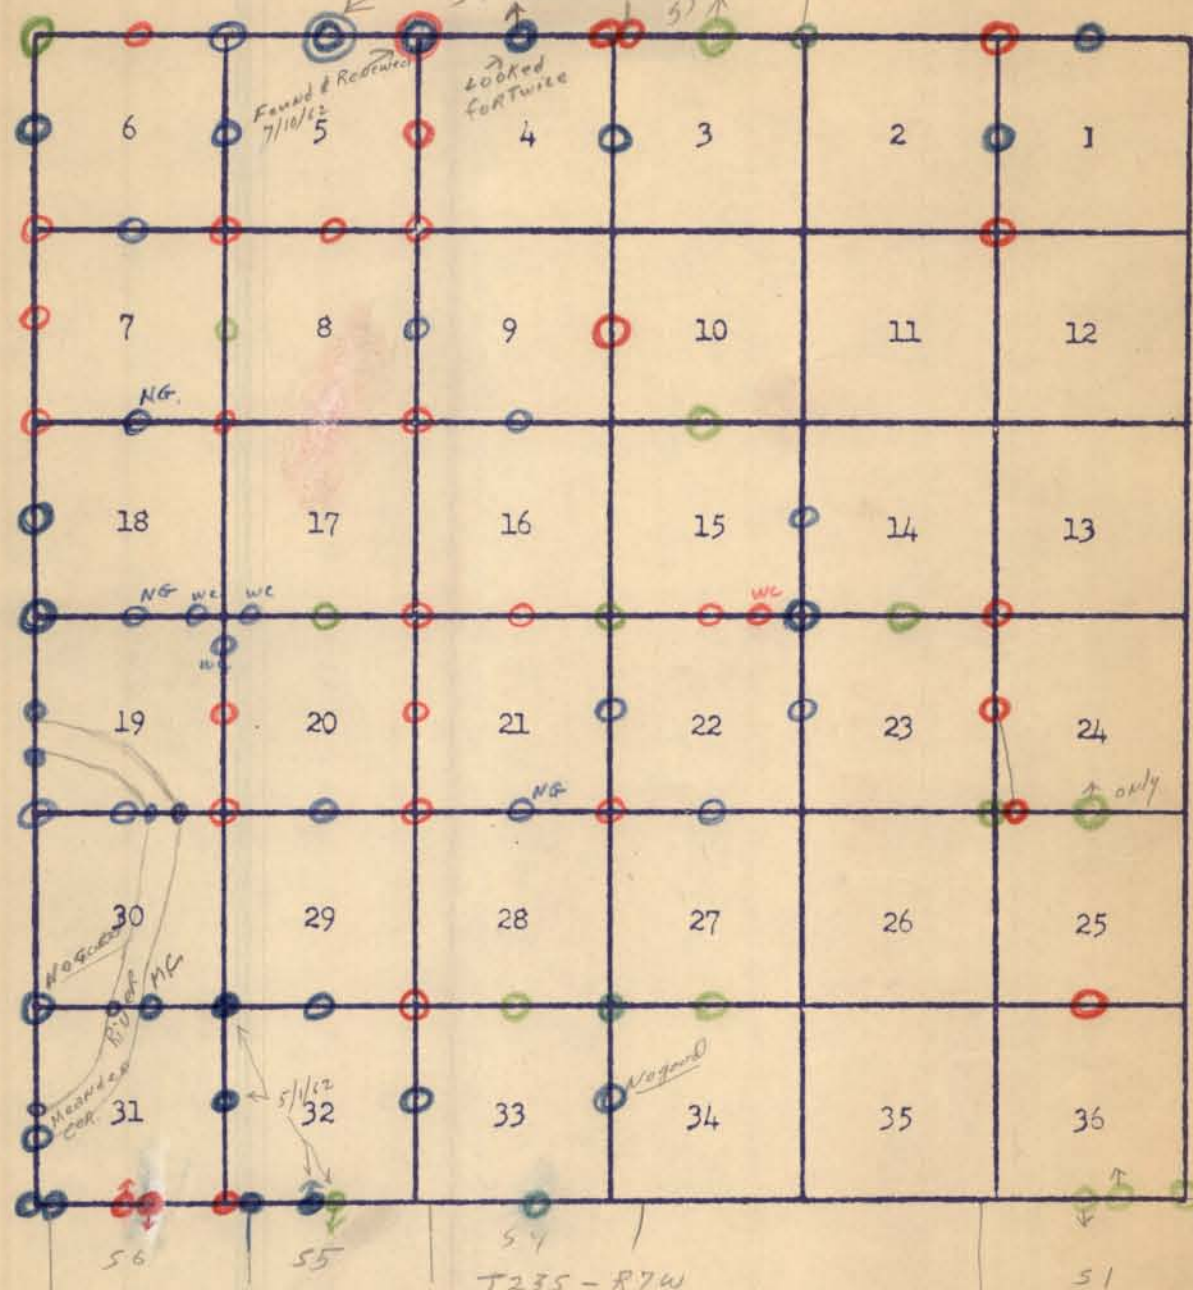

T 225
R 8 W

T 225
R 6 W

- - CORNERS Found & Renewed
- - CORNERS Found & used
- - CORNERS NOT found

11 20
5