


N. Godfrey  
V. Tracy  
C. Putnam

March, 1962

FILED  
RECEIVED  
APR 9 1962

COUNTY SURVEYOR  
DOUGLAS COUNTY, ORE.

TWP 22S., RGE 7W., W.M.

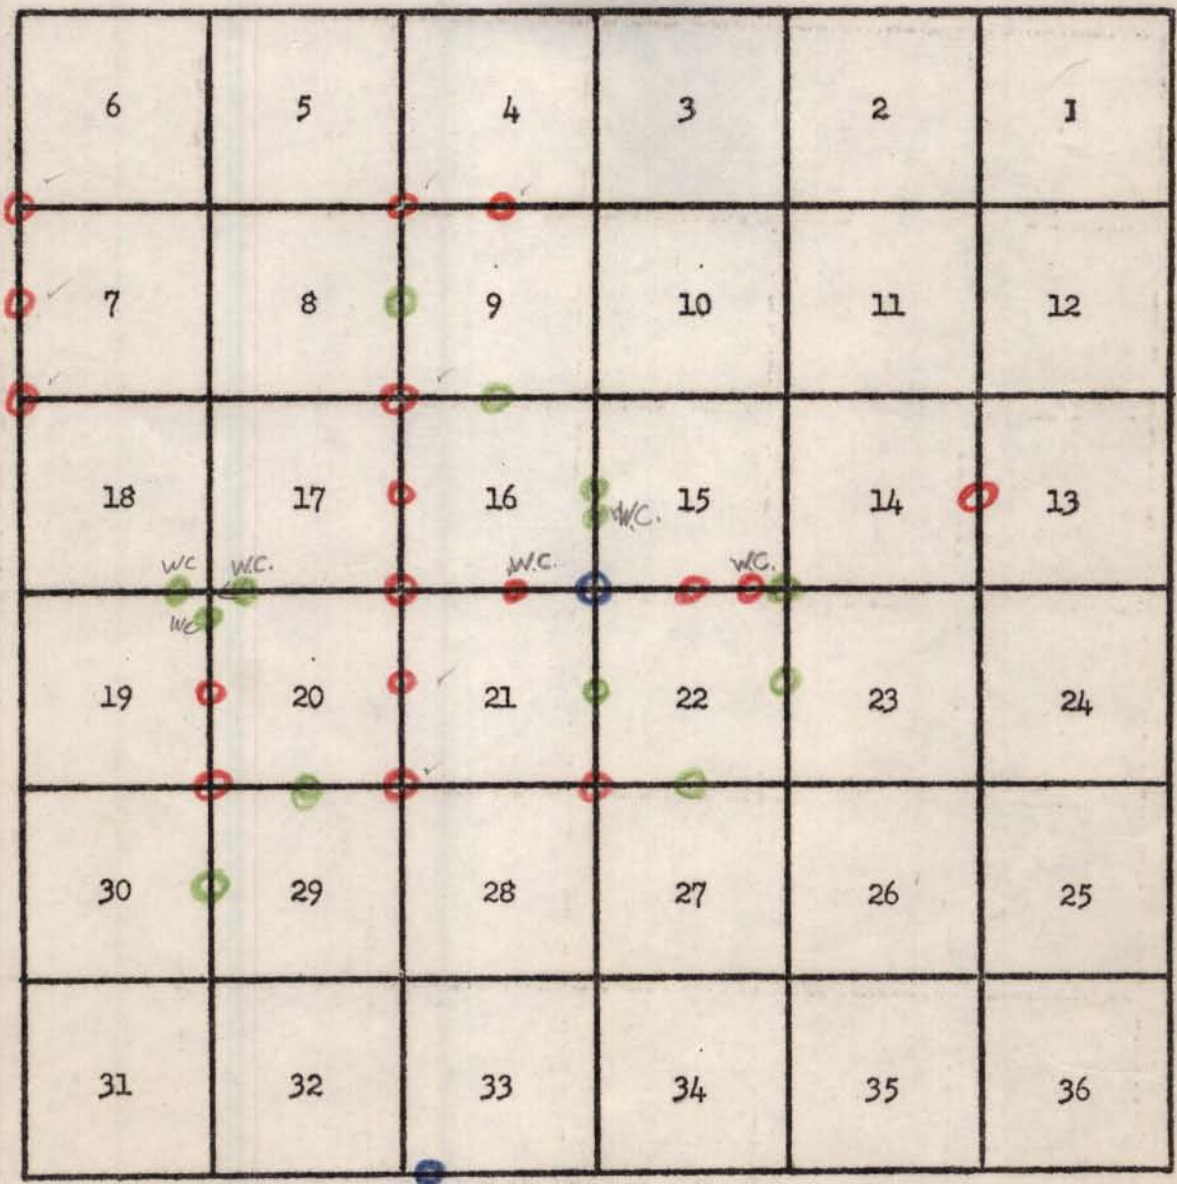

- - CORNERS Found & Renewed
- - CORNERS Searched for & Not Found
- - CORNERS Found & used as is