

RENEW 1/4 COR. 15 | 14 T 31 S R 6 W

FOUND - ORIG 5 NOW DEAD LAUREL

S 58° W 2.6' SHOWS SCRIBING.

SEE BT DOWN

SET BRASS CAP AT CORNER

MND. COUNTY SURVEYORS OFFICE 1962

1/4 S 15 | S 14 T 31 S R 6 W.

NEW B.T.S.

14" R. FIR BEARS S 48° E 15.6'

SCRIBED 1/4 S 14 CS BT.

13" R. FIR BEARS S 28° W 7.6'

SCRIBED 1/4 S 15 CS BT.

FI NOTE - COR. 15 80' WEST OF LOG ROAD,

FILED

AUG 31-62

RECEIVED

J. B.

CCAUG 31 1962

J. P.

D.

B. S.

COUNTY SURVEYOR

M. S.

DOUGLAS COUNTY, ORE.


+ \* ✓ ✓

CS 52/25-14

Section 15

Twp 31 Rge 6 W

Date: 8-29-62

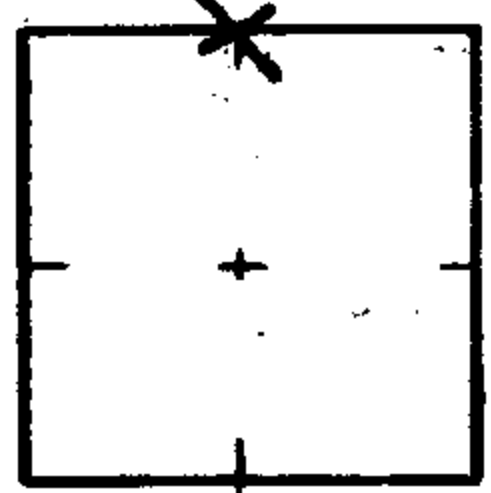

How is corner identified? wooden post, 1 B.T.

Condition of corner: Fair, but wooden post could be lost.

Best route to reach corner: Silver Butte road to Sec. 15, take RPPA road # 316-1 to within 50 ft of NW corner.

Quadrant	NE	NW	SE	SW
Species & Size				
Dist. & Bearing				
Condition of Scribe	<b>RENEWED</b>			
Original or Resurvey				
Appearance of B.T.				
Tags, Marks, etc.				

Other Remarks:

Inv. # 531  
8/31/62

BGM

Signed

52/25-14