

RENEW $\frac{6}{7} \frac{15}{8}$ T 315 R 6 W

FOUND - ORIG 8" NOW 10" ROTTED

LAUREL SNAG, N 50° E 1 1/2' ORIG

2 1/2" NOW 40" FIR S 36° E 2 1/2'

SHOWS SCRIBING. ORIG 2 1/2" NOW

25" LAUREL N 16° W 2 1/2' SHOWS

SCRIBING. WE ALSO FIND STUMP

HOLE THAT CHECKS FOR SW BT

SET BRASS CAP AT COR. NIND,

COUNTY SURVEYORS OFFICE, 1963

DIETZEN NO. 385-6

56 | 55 T 315 R 6 W
57 | 58

NEW BTJ.

RESCRIBE NOW 25" LAUREL N 16° W

252' S 6 C S BT

8" R. FIR BEARS N 54° E 43.5'

SCRIBED 55 C S BT

10" R. FIR BEARS S 14° W 52'

SCRIBED 57 T 315 R 6 W C S BT

SET 10-63
H.B.
S.D.

+ X O

C. S. File No. 52/25-16

Section 5 Twp 31S Rge 6W N Date: 8-26-63


How was corner identified? Same one chopped out the

scribe many years ago

Condition of corner: Good right near but

only one BT left w/ BUT NOT

Best route to reach corner: Cammell Creek Road - Jeep

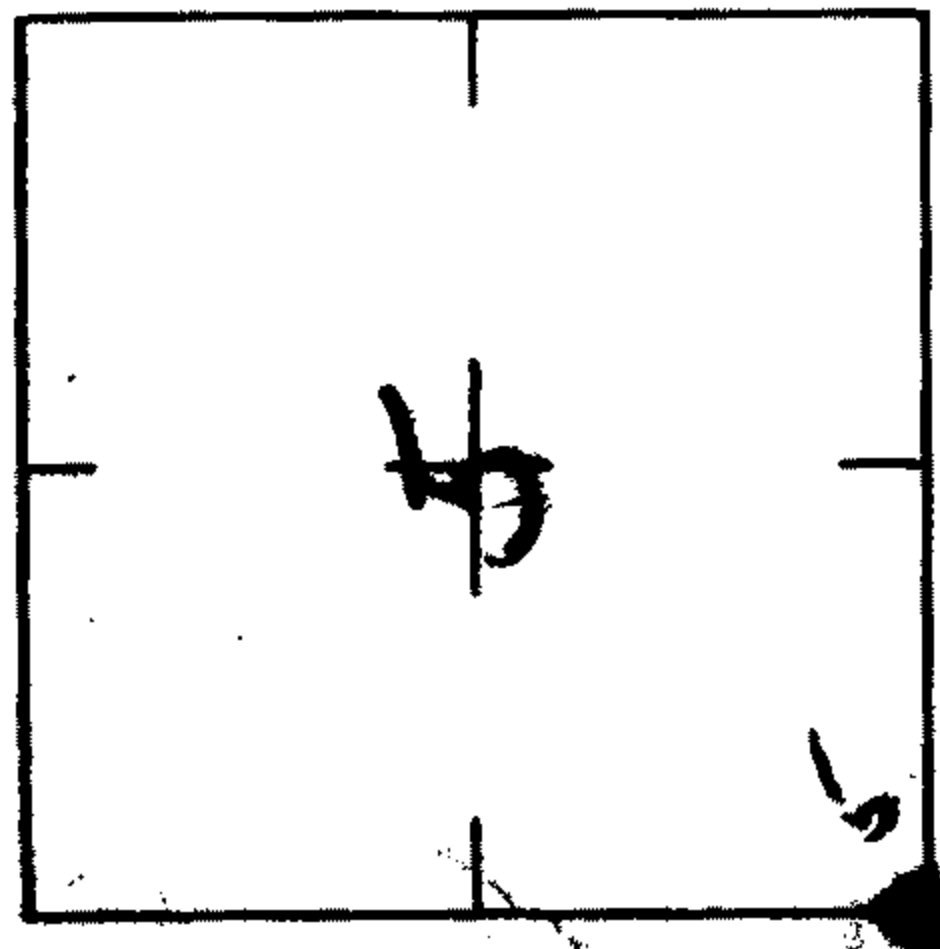

Road to Sec 18 - Jeep Road to Sec 5 - Surveying
Road Points to BPR STA 477407 ⁸⁸ 185' from Cor
Other Remarks:

Road proposed into
area, either BPR or
Timberlake Rd.

Quadrant	NW	NE	SW	SE
Species & Size				3 1/2" D FIR
Dist. & Bearing				S36E 25'
Condition of Scribe				GOOD
Original or Resurvey				ORIGINAL
Appearance of B.T.				BUT NOT
Taps, Marks, etc.				Tag 9/9/99

Shyrd Vandenberg
 Signed

CS 52/25-16