

JUNE 4, 1964

T31S R6W

BS
MS
MD

17/16
20/21

FD. 14" (NOW 17") LAUREL N 50 E 30.4'

SCRIBING VIS. "31-6-16"

10" (NOW 12") LAUREL S 51 E 42.2

BADLY BURNT

20" (NOW 29") LAUREL S 90 N 68.2

"B.T." VIS. BADLY BURNT

18" (NOW 27") LAUREL N 60 W 69.3

SCRIBING VIS. "31S R6W 517

SET BRASS CAP

MKD. T31S

17/16 R
20/21 G
W

1964

COUNTY SURVEYORS OFFICE

NEW B.T.'S

5" FIR S 46 E 36.2'

SCR. S 21 C.S. B.T.

5" FIR S 10 W 15.2

SCR. S 20 C.S. B.T. 52/25-17
C.S. File No.

+ * O

DIETZEN 20 385-6

Paul E. ...

Section 2012


Twp 31S

Rge 6

W

Date: 12/12/58

How was corner identified? Post 2" x 2" x 2"

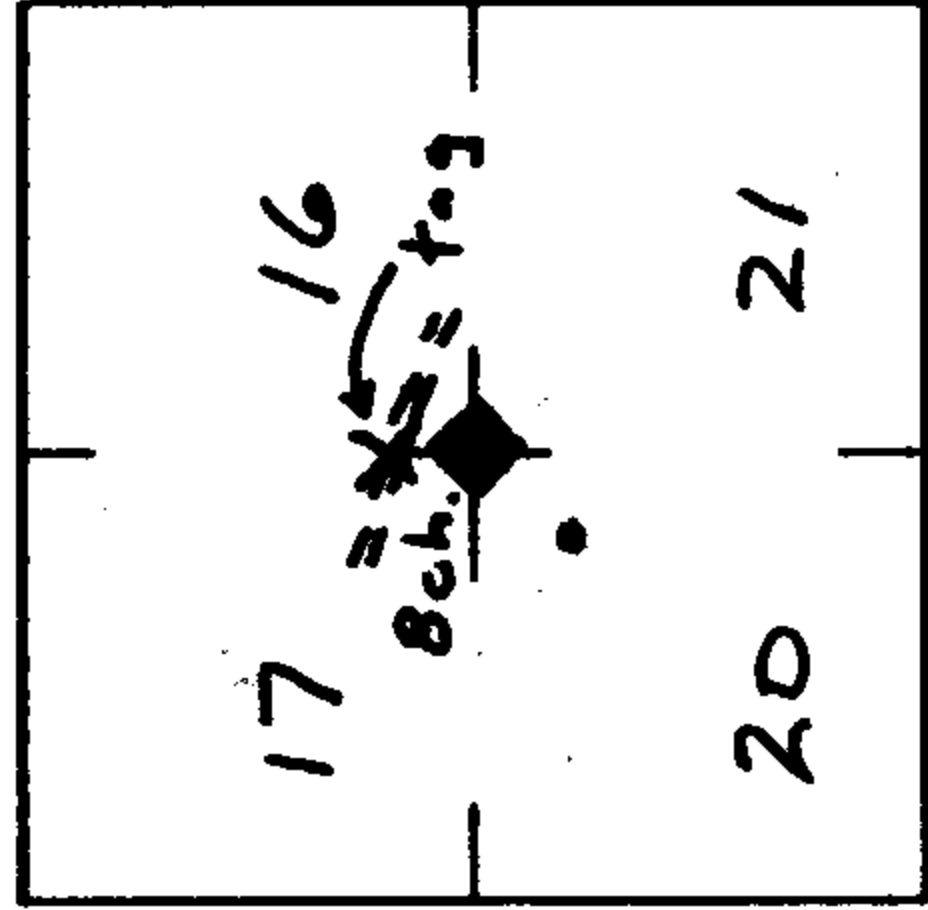

Condition of corner: Good

Best route to reach corner:

Quadrant	NE	NW	SE	SW
Species & Size	Madrone 16"	Madrone 24"		Madrone 29"
Dist. & Bearing	N46E 26'	N60W 70'		S39W 71'
Condition of Scribe	Good	Good		Good
Original or Resurvey	Resurvey	Resurvey		Resurvey
Appearance of B.T.	366	3126WS17		B
Tags, Marks, etc.	-	-		-

Other Remarks:

Bob Baker
Signed
CS 5245-17