

REN T 31 S R 6 W

COR.
SECS

$\frac{8}{17} \frac{9}{16}$

FD. DOUG. FIR (NOW 39" DIAM.)

N 72° E 20⁵ FT. — SOME BARK

SCRIBING & VISIBLE ON OLD BARK BLAZE
— A "T" & PART OF AN "S"

NO TRACE OF ANY OTHER B.T.S.

FD. — LOCATIONS FOR TREES ARE IN
OLD CAT RD. & BULLDOZED AREAS.

AT COR. SET IRON PIPE WITH
BRASS CAP MKD. "COUNTY SURVEYOR'S
OFFICE 1964 T 31 S R 6 W $\frac{58}{59}$
 $\frac{517}{516}$

BLAZE & RESCRIBE (IN WOOD)

39" DOUG. FIR N 72° E 20⁵ FT. MKD.

"T 31 S R 6 W 59 CS BT"

BLAZE & SCRIBE NEW TREES:

30" DOUG. FIR S 69° W 60⁶ FT.

MKD. "T 31 S R 6 W 517 CS BT"

10" MADRONE S 43^{1/2}° E 48⁸ FT.

MKD. "S 16 CS BT"

20" INCENSE CEDAR N 16° W 56⁴ FT.

MKD. "T 31 S R 6 W 58 CS BT"

COR. LIES ON FAIRLY STEEP S.W.

SLOPE, NEAR BOTTOM OF SMALL DRAW
RUNNING S.E.

JUNE 12, 1964

M.G.


M.D.

FOX ✓ *Milo E. Godfrey*

C.S. File No. 52/25-18

Section 8 Twp 31 Rge 6 Date: _____

How was corner identified? Scrubbed B.T.S

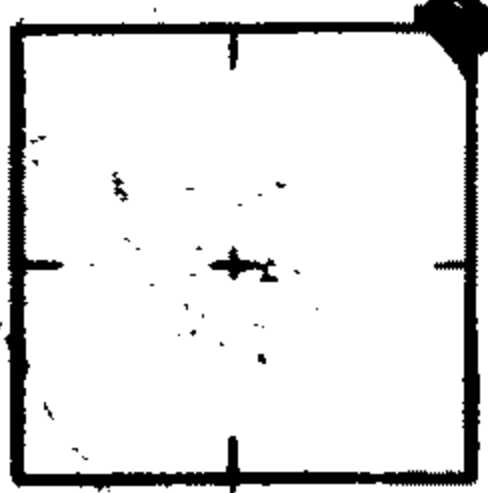

Condition of corner: _____

RENEWED
 JUNE 12, 1964
 Hubert Godfrey
 Best route to reach corner: Council Creek - Middle Cr
tag on road

Quadrant	NE	NW	SE	SW
Species & Size	24" FIR	N72°E	31	1ks
Dist. & Bearing				
Condition of Scribe				
Original or Resurvey				
Appearance of B.T.				
Tags, Nails, etc.				

Other Remarks
low elevation
little snow
and the gate
is open.
Tags on road
R.J. Henderson
 Signed _____
 CS 52/25-18