

REM.

T 31 S R 6 W.

1/4 S 8 / S 17

FD. MADRONE (NOW 21" DIAM.)

N 18° E 11 1/2 FT. - PREVIOUSLY
OPENED - GOOD SCRIBING VISIBLE "45"

F.D. PORTION OF ROTTEN LAUREL
ON GROUND IN GENERAL LOCATION
OF SOUTH B.T. - IMPOSSIBLE TO
DETERMINE WHERE IT STOOD.

AT COR. SET IRON PIPE WITH
BRASS CAP MKD. "COUNTY SURVEYOR'S
OFFICE 1964 T 31 S R 6 W 1/4 S 8 / S 17"

BLAZE + SCRIBE NEW TREES.

8" DOUG. FIR S 74° E 90 FT.
MKD. "1/4 S 17 CS BT"

8" DOUG. FIR N 83° W 70 FT.
MKD. "1/4 S 8 CS BT"


JUNE 12, 1964

Milo E. Jeffrey

M.G.
M.S.

+ X ✓

Section 8 Twp 31 Rge 6 W Date: _____

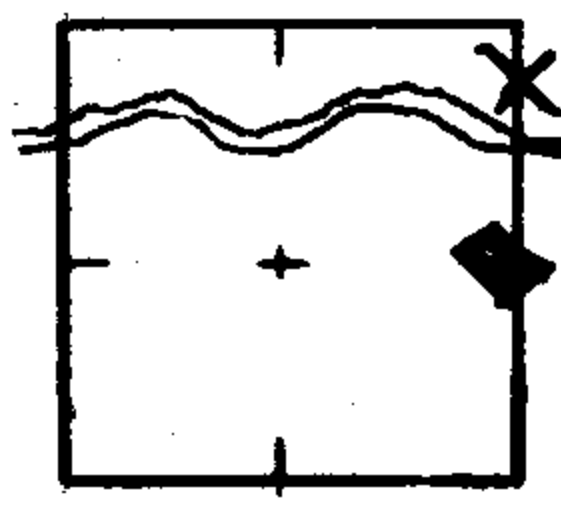

How was corner identified? By scribe on BT
below

Condition of corner: Bad shape

Best route to reach corner: Council Cr. -
Tag on road

RENEWED
 JUNE 12, 1964
 Phil G. Spafford

Other Remarks: _____

Quadrant	NE	NW	SE	SW
Species & Size				8"
Dist. & Bearing				3081N 17/ks
Condition of Scribe				good
Original or Resurvey				—
Appearance of B.T.				
Tags, Marks, etc.				

R. J. Henshewson
 Signed
 CS52425-19