

CORNERS SEARCHED FOR
& NOT FD.

T 31 S R 6 W

COR. $\frac{5}{4}$ ✓
SECS. $\frac{8}{9}$

FD. LARGE OLD GROWTH FIR WITH
AXE "X" CUT IN BARK - TREE APPROX.
13 CHS. WEST OF CROSS & BLAZE ON
LAUREL TREE BESIDE ROAD ALONG RIDGE
TOP. - NO NOTCHES NOR SCRIBING FD.
ON FIR. - FD. LAUREL TREE S 58° W
72² FT. - (NOT 75² FT.) WHICH HAD
BEEN OPENED SOME YEARS AGO. -
NO SCRIBING OR OTHER OLD MKS. FD.
ON LAUREL. - NO OTHER LAURELS FD.
WHICH FIT BEARING OR DIST. FROM
LARGE FIR. - DID NOT RENEW.

$\frac{1}{4}$ S | S ✓
8 | 9

FD. SQUARED UP SMALL FIR
STUMP AT APPROX. LOCATION FOR
 $\frac{1}{4}$ COR. - DID NOT FIND COR. TREE
NOR EITHER B.T. CALLED FOR IN
FIELD NOTES.

JUNE 22, 1964

Milo E. Godfrey

M.G.
M.S.


Section 8

Twp 31 S

Rge 6 W

N

Date: 4/23/64

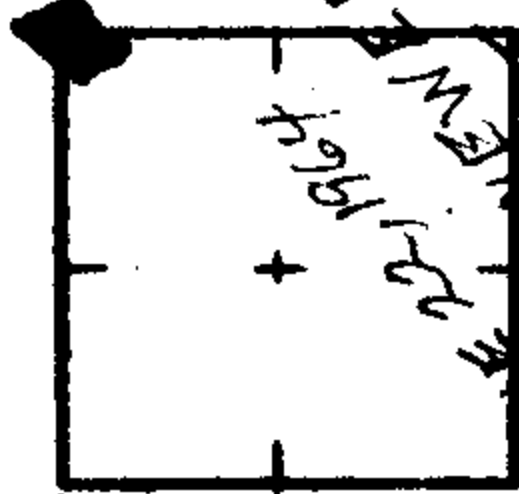

How was corner identified? Large 72" FIR

A notch on EAST 5 notches on South

Condition of corner: Bad

Best route to reach corner: From Middle Cr Road via Council Creek.

Other Remarks:

Quadrant	NE	NW	SE	SW
Species & Size				<u>12 laurel</u>
Dist. & Bearing				<u>558° W - 115/ks.</u>
Condition of Scribe				
Original or Resurvey				<u>FOUND 1953 BY GLEN BAUGHMAN</u>
Appearance of B.T.				<u>According to our records.</u>
Taps, Marks, etc.				<u>Signed R.J. Hamilton</u>

C S 52 / 26 - 20