

Renew $\frac{1}{4} \frac{517}{520}$ T315 R6W

Fd. at cor Both original BT's -

12" Now 28" Pine N. 80° W. 58 L

open & shows " $\frac{1}{4}$ S BT" scribe.

40" Now 40" Pine (SNAZ) S. 40° E. 44 2 ft.

Recorded 25 S. 45° E. We do not open.

Set 1" I.P. & Brass Cap MKD.

"COUNTY SURVEYOR'S OFFICE 1964

T315 R6W $\frac{1}{4} \frac{517}{530}$ " & MK. New BT's -

6" D. FIR S. 9° E. 7⁸ ft.

MKD " $\frac{1}{4}$ S 20 CS BT"

6" D. FIR N. 6° W. 23⁴ ft.

MKD " $\frac{1}{4}$ S 17 CS BT"

Oct. 20, 1964

U.R.T.

M.D.


J.B.

~~U.R.T. R.A.~~

AX ✓ ○

C.S. File No. 52/25-28

Position 20 Twp 31 Rge 6 Date: _____

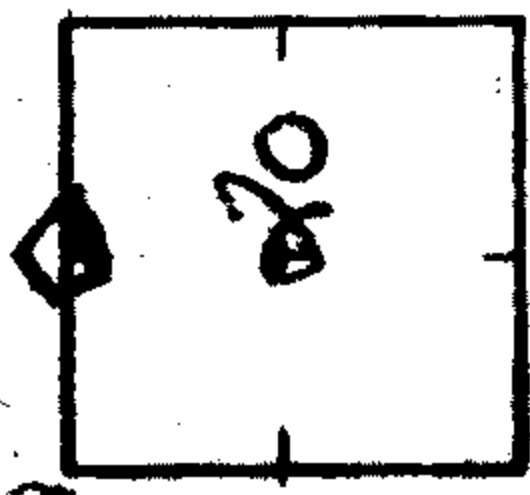

How was corner identified? BY FIELD NOTES &

SCRIBING ON THE 12" PINE BZ

Condition of corner: ONE B.T. good

BOTH B.T. IN PLACE.

Best route to reach corner: up COUNCIL CR.

FILED TO THE FORKS IN RD ON TOP OF R.

RECEIVED

Other Remarks:

Quadrant	NS	NN	SEK PINE = 40' EM
Species & S/AUG 28 1964		PINE	about 18"
Dist. & Bearing			
COUNTY SURVEYOR			
ORIGINAL OF HAMILTON COUNTY, ONT.			
Appearance of B.T.			
Tag, Marks, etc.		CS 52/25-28	

*check with B.S.P.
in case of any
inquiries*