

Renew $\frac{1}{4}$ $\frac{515}{522}$ T315 R6W

Fd. at cor Both BTs -

22" now 30" D. FIR S. 72° W. 15 8 ft.

Badly burned snag.

22" now 34" D. FIR N. 60° E 7 9 ft.

alive & shows "4 5" in bark.

We set 1" I.P. & BRASS CAP MKD. COUNTY

SURVEYOR'S OFFICE 1964 T315

R6W $\frac{1}{4}$ $\frac{515}{522}$ " & MK. NEW BTs -

19" D. FIR S. 40° W. 27 9 ft.

Mkd. $\frac{1}{4}$ S 22 CS BT"

12" D. FIR N. 10° W. 47 5 ft.

Mkd. $\frac{1}{4}$ S 15 CS BT'

Nov. 5, 1964

V.R.T.
M.D.
J.B.

Garrett


+ 576

C. S. File No. 52/25-29

Station 22

Top 315 Base 6W

Date: 10/22/64

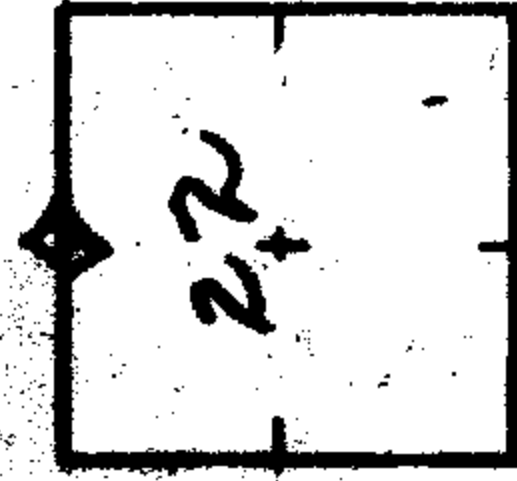

How was corner identified? Bearing tree

Condition of corner: Poor

Removal

Best route to reach corner: Hawk Mine to line crossing, fog
Take road past Black

Quadrant	NE	NW	SE	SW
Species & Size	28" Fir	28" Fir		
Dist. & Bearing				
Condition of Scribe	Poor	Poor		
Original or Survey	Orig	Orig		
Appearance of I.T.	Poor	Poor		
Spec. Mark, etc.	No	Yes		

Other Remarks:

Faint 4 on
bearing tree.
Bark scribe.

Floyd Meyer
CS 52125-29