

RENEW $\frac{1}{4}$ 520 | 521 T315 R6W

Fd. squared post at cor. & one orig.

BT-

6" Now 19" cedar S. 65° W. 85 ft.

we open & find " $\frac{1}{4}$ " Scrise.

No trace of other original B.T. or

BT recorded in Ren. # 19. Set

1" I.P. & BRASS CAP MKD. COUNTY

SURVEYOR'S OFFICE 1965

T315 R6W $\frac{1}{4}$ 520 | 521"

MARK NEW BTs -

19" D. FIR N. 55° E. 72° ft.

Mkd. " $\frac{1}{4}$ 521 CS BT"

22" cedar N. 66° W. 71⁶ ft.

Mkd. " $\frac{1}{4}$ 520 CS BT"

This cor. lies approx. 60° ft

South of SPRING BRANCH

flowing N. W.

MAR. 5, 1965

J.R.T.
J.B.

FILED

RECEIVED

[Handwritten signature]

MAR 5 1965

COUNTY SURVEYOR -


DOUGLAS COUNTY, ORE.

C. S. File No. 52/25-30

FX #119

Section 20 Twp 31 Rge 6 Date: FEB. 10, 1965

How was corner identified? Reminders line
Corner of Rd to Middle Cr. "Rock Road."

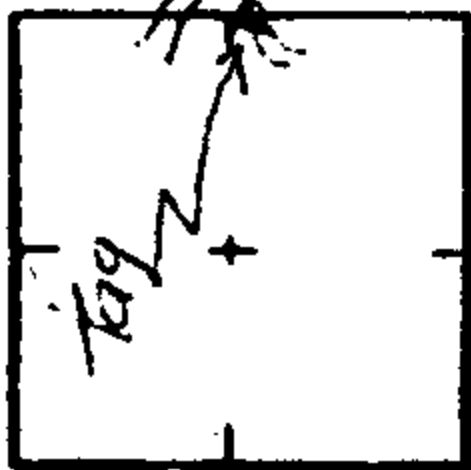

Condition of corner: Should have 1PBC

Rem. #19 & removed B.T.'s

Ed. 12" cedar 5 1/2 ft W 2 1/2 ft

Mkd. 18" FIR N. 81° E. 177° E +

Best route to reach corner:

Rt Co Road up Campbell Cr.

Brydon 1957

Other Remarks:

Quadrant	NE	NW	SE	SW
Species & Size				20" CEDAR
Dist. & Bearing				505' W 13' N
Condition of Scribe				good
Original or Resurvey				original
Appearance of B.T.				good
Tags, Marks, etc.				Tag

Bibb Humborn
Jerry Clark
 Signed

CS 52/25-30

