

Reviewed $\frac{78}{1817}$

T315 R6W

Found -

Orig 40" Douglas Fir Now 59" N45W 51/2

Shows bark scribe Good Tree

Orig 24" Douglas Fir N72E 50 1/2

Snag, Shows bark scribe

Orig 12" Yew Now 18" S1W 79 1/2

Scribe visible, good Tree

Orig 20" Douglas Fir S50E 75 1/2

Burnt snag

Set Brass cap at cor.

Mad County Surveyors OFF. 1965

T315 R6W $\frac{78}{1817}$

NEW B.T.S.

59" Douglas Fir N45W 46

Scribed T315 R6W S7 BT

36" Douglas Fir N31E 68

Scribed T315 R6W S8 BT

49" Douglas Fir S21E 77 1/2

Scribed T315 R6W S17 BT

Sept 21, 1965

#82

+X


C. S. File No. 52/25-33

J. C. B.

J. M. G.

Section 17 Twp 31 Rge 6 W

Date: _____

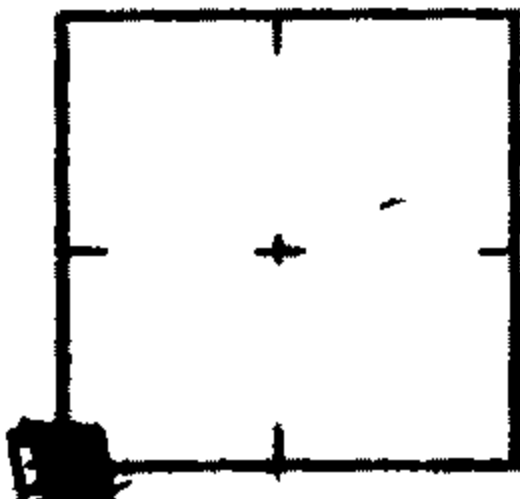

How was corner identified? TWO ORIG BARK SCRIBED

B.T.'s

DESCRIPTOR: Deep ROAD THROUGH 1857

ON Top of ridges drop off ridge

Best route to reach corner: FULL CUT A FLAGGED SIDE

LINE ORANGE - PART of SECTION LINE IS ERASED

Other Remarks:

Quadrant	NE	NW	SE	SW
Species & Size				
Dist. & Bearing				
Condition of Scribe				
Original or Resurvey				
Appearance of B.T.				
Tags, Marks, etc.		CS	52/25-33	

M. H. [Signature]
Signed B. L. M.