

FRED M. DARBY
COUNTY SURVEYOR



PHONE ORCHARD **2-3311**
EXTENSION 28

COUNTY OF DOUGLAS
OFFICE OF THE SURVEYOR
ROSEBURG, OREGON
June 12, 1962

Mr. George Wenderoth
Azalea, Oregon

Dear George:

We cannot find record of the Section Corner to Sections 7, 8, 17 and 18, Township 31 South, Range 7 West, W. M., which you apparently renewed in 1961. The surveyor inquiring about the corner found your pipe and four bearing trees, rescribed, three of which were originals. He also mentioned that the work was done for C. & D. Lumber Co.

We would appreciate receiving the information on this renewal as soon as possible.

Very truly yours,

A handwritten signature in cursive script that reads "Fred M. Darby".

Fred M. Darby
County Surveyor

FMD:11

Dear Fred, - Worked on this last fall was to finish lines this spring but owing to trouble with my back was unable to do so. My notes were to be picked up by C. & D for the surveyor who finished the job. Here are the notes on the corner as set by me. You will notice that the bearing of original B.T. do not jibe with original notes.

40" Fir N. 41° 50' W. 23.7 O.B.T.
40" Fir S. 82° 06' W. 27.8 O.B.T.
36" Fir S. 44° 45' E. 11.4 O.B.T.
18" Fir N. 53° 34' E. 11.4

over.

Q1 ✓

S. S. File No.

52/29

I ran line South $\frac{1}{2}$ mile but found $\frac{1}{4}$ Corner destroyed by new road constructed along Cow Creek. also ran West $\frac{1}{2}$ mile but could find no trace of $\frac{1}{4}$ Corner there, stopped work at this point as C. & D. were going to build a road in and wouldn't start until this spring as it would make the work more accessible to reach. So have no notes on true line West or South.

Line North from this Corner was run by someone else to $\frac{1}{4}$ Cor. North. and the line I ran South is on the same bearing but line (old) blazed from Corner ~~to~~ West bore strongly N. of W. so followed them in hopes of finding the $\frac{1}{4}$ Cor. but could not. Was going to run another $\frac{1}{2}$ mile this year but was unable to at the time they wanted it.

Yours
George.

FILED
RECEIVED

JUN 18 1962

COUNTY SURVEYOR
DOUGLAS COUNTY, ORE.

T. 32 S. R. 4 W.

Var. 20'

Cor. 3-4-33-34 - 1" I.P. Brass Cap.

Found 20" Fir S. 46° 30' E. Good 4.6

14" Ash S. 81° 20' W. Good. 29.3

24" Fir N. 39° 45' W. No tree Avail. 27.0
Blown down

Scribe 12" Cedar N. 48° 50' E. 15.9 - New. BT.

40" Fir N. 89° 15' E. 21.5 Orig. Stump.

Dec. 5, 1962


Geo. Wenderoth
Turned in by *Geo. Wenderoth*

NOT SIGNED


33 / 34 T 31-4

4 / 3 T 32-4

Renewal No. 60

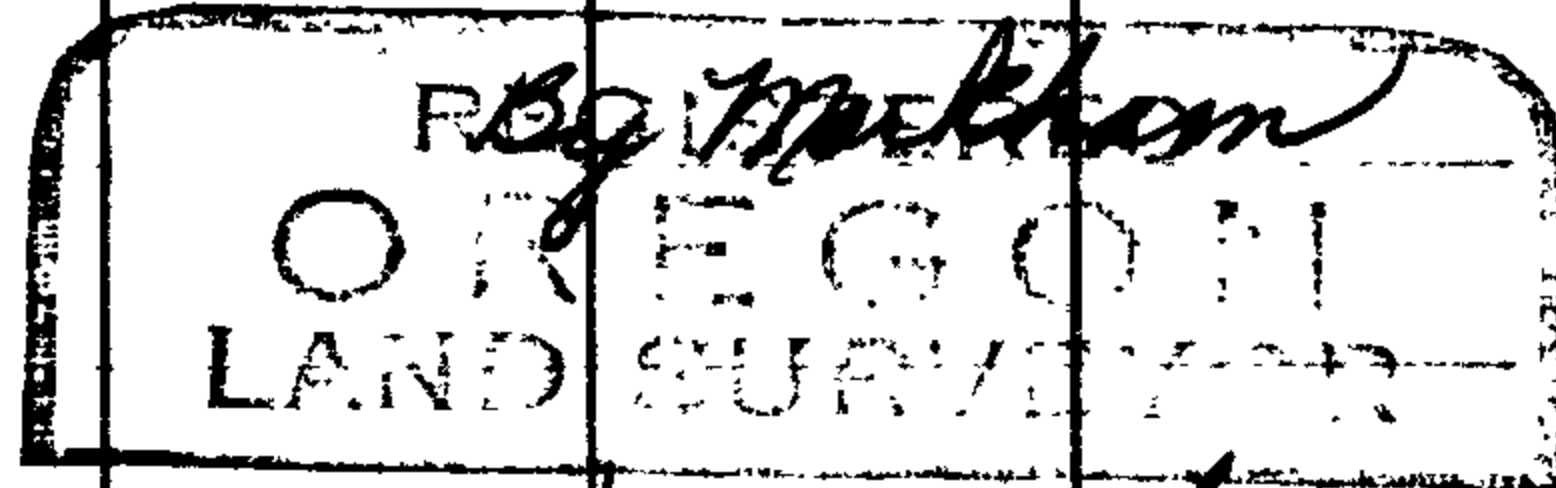

Geo. J. Wenderoth

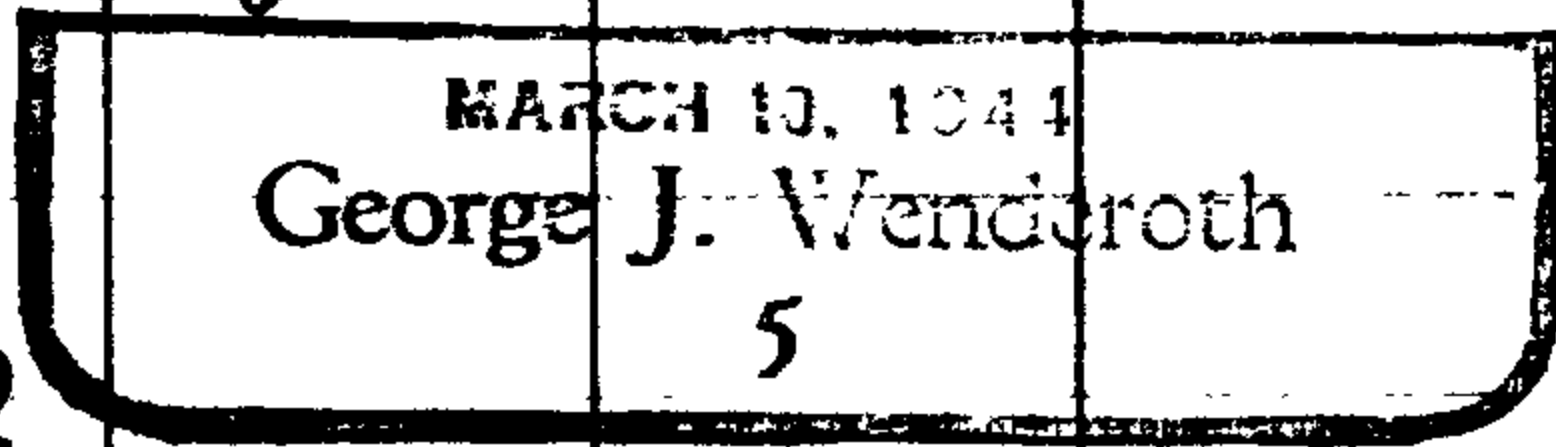

FILED

RECEIVED

DEC 7 1962

COUNTY SURVEYOR
DOUGLAS COUNTY, ORE.

+ 00 ✓

C. S. File No. 52/29

Renewed $\frac{3}{4}$ Cor. East side Sec. 18, T. 32S., R 4W. June 18, 1960
Found stumps of both witness trees as renewed
before and 1" Iron Pipe.

Put in new trees as follows.

10" Fir N. $12^{\circ} 49' W.$ 69.1 ft.

24" Cedar S. $48^{\circ} 16' W.$ 155.1 ft.

Geo J. Wundroth Deputy

✓ C. S. File No. 52/29