

Renew Sec. Cor. 

511	512
514	513

 T255 RIW

Fd. No Trace of Brass/Stone called for in orig. Field Notes. B.T.s 211

Destroyed except one. 25 follows 30" Now 31" D. FIR N. 10° W. 42° ft.

2 live shows "511 RE 4079 BT"

Recorded 25 N10° E. in Ren. #28

BRASS Cap MK'd COUNTY SURVEYORS OFFICE 1966 T255 

511	512
514	513

 RIW"

MK. New B.T.s -

20" I. cedar N. 40° W. 50<sup>3</sup> ft.

MK'd. T255 RIW 511 CS BT"

9" I cedar S. 20° W. 39<sup>2</sup> ft.


MK'd. T255 RIW 514 CS BT (4 ft. off ground)

No Trees available to East, Due To Logging. Cor. Lies on N.-S. cutting line - cutoff to East.

August 1, 1966

U.R.T.  
J.B.  
J.H.

FILED  
RECEIVED

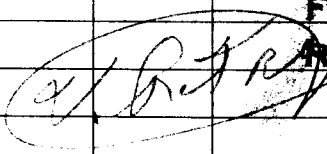

AUG 1 1966

COUNTY SURVEYOR  
DOUGLAS COUNTY, ORE.

\* 62  
O.H. J.W.B.

C.S. No. 3250-18