

Review $\frac{1}{4}$ 527/526 T255 RIW

Fd. B.T.'s as follows -

Orig. 15" Now 26" Hemlock S. 35° W. $5^{\frac{3}{4}}$ ft.

Recorded as FIR - previously opened &
Shows "S" scribe, alive

Orig. 18" Now 32" Hemlock N. 68° E. $23^{\frac{1}{2}}$ ft.

Alive - shows scar. - wedge not open,
set 1" I.P. & BRASS CAP MKd. "COUNTY

SURVEYORS OFFICE. 1966 T255

$\frac{1}{4}$ 527/526 RIW " & MK. New B.T.'s -

10" Hemlock S. 58° W. $10^{\frac{1}{2}}$ ft.

Mkd. " $\frac{1}{4}$ 527 CS BT"

17" Hemlock N. 29° E. $44^{\frac{8}{16}}$ ft.

Mkd. " $\frac{1}{4}$ 526 CS BT"

COR. Lies on moderate NE slope

approx. 120 ft. S. of old Jeep

Trail course NE-SW, on top of


spur.

August 2, 1966

V.R.T.

J.B.

J.H.

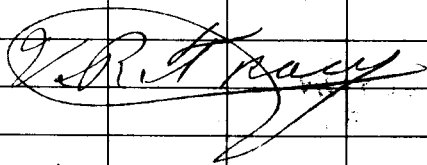

#60

OK. J.W.B.

G.S. No. 52/30-20