

Renew  $\frac{1}{4}$  514 | 513 T255 RIW

Fd 6" x 8" x 14" Basalt Stone Firmly set  
A MKd. " $\frac{1}{4}$ " on W. face. & one orig.  
BT. -

14" Now 16" FIR 5, 62° W, 8.8 ft.

Recorded to be N. 33° W, 18.5 ft.

Previously opened & shows " $\frac{1}{4}$ " scribe.

Also 2" $\frac{1}{2}$ " steel pipe set along side  
Rock & B.T. Recorded in Ren. #29

25 follows -

32" FIR N. 45° E, 22° ft

shows " $\frac{1}{4}$  513 RE4079 BT" Back scribe.

We set 1" I.P. & BRASS CAP MKd.

"COUNTY SURVEYOR'S OFFICE 1966

T255  $\frac{1}{4}$  514 | 513 RIW" & MK New BTs:

6" Yew N. 80° W 36.5 ft.

Mkd. " $\frac{1}{4}$  514 CS BT"

12" D. FIR N. 5° E, 24.1 ft.


Mkd. " $\frac{1}{4}$  513 CS BT" & CRUISER'S MK "I"

August 2, 1966

V.R.T.

J.B.

J.H.

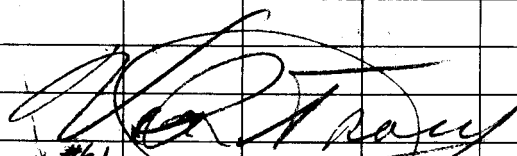

\*#61

O.K. J.W.B.

C.S. File No.

52/30-2