

Review  $\frac{1}{4}$  531 only T25S R1E & R1W  
Fd. 1927 G.L.O. BRASS cap MKD " $\frac{1}{4}$  531"  
Nearly out of Rock Mound - we Reset  
in new mound of stone 2 ft. high  
Both 1927 B.T.S. alive & show scars  
we Rescribe -


14" Now " D. FIR S.  $28^{\circ}$  E. 29 ft.  
Rescribed " $\frac{1}{4}$  531 CS BT"

8" Now 13" D. FIR N.  $41^{\circ}$  E. 4 ft.  
Rescribed " $\frac{1}{4}$  531 CS BT"

COR. Lies 50 ft. West of Canton  
Creek Course South on Right  
high BANK. & approx. 40 ft S. of the  $\frac{1}{4}$  of  
S. 36 of T25S R1W.

OCT. 13, 1966

U.R.T.  
J.H.  
D.W.

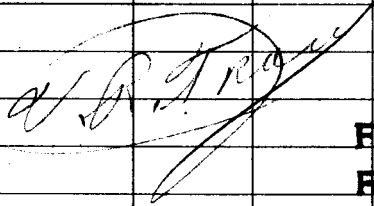

FILED  
RECEIVED

OCT 13 1966

COUNTY SURVEYOR  
DOUGLAS COUNTY, ORE.

#8-R1E  
#70  
\*

O.K. J.W.B.

C.S. File No. 52/30-24