

Renew Closing Cor. T255 NW  $\frac{518}{519}$  R1E

Fd. 1927 G.L.O. BRASS Cap properly

Mkd. & 1927 B.T.s as follows -

8" Now 11" FIR N. 61° E. 30  $\frac{1}{2}$  ft.

Now snag - Shows SCAR - we do not open

8" Now 10" FIR S. 40° E. 27  $\frac{1}{2}$  ft.

Now snag - Shows SCAR - we do not open.

We MK. New B.T.s -

36" cedar S. 28° E. 7  $\frac{1}{4}$  ft.

Mkd. T255 R1E 519 CC ~~CS~~ BT

13" D. FIR N. 1° E. 31  $\frac{1}{2}$  ft.

Mkd. T255 R1E 518 CC CS BT

This cor. Lies on S.W. slope

approx 150 ft. south of cor to


Sec. 5  $\frac{13}{24}$  of 25-1W, Rem #22, O.K.

Nov. 1, 1966

V.R.T.  
J.H.  
D.W.

FILED

RECEIVED

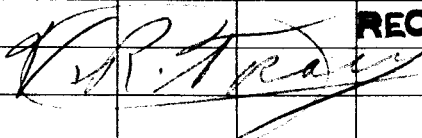

OCT 31 1966

COUNTY SURVEYOR  
DOUGLAS COUNTY, ORE.

#12-T25-1E  
\*#77-T25-1W  
O.K.

J.W.

C.S. File No. 52/30-44