

Found. Sec. Cor. <sup>54 | 53</sup> 59 | 510 T255 RIW

Fd. 7/4" steel pipe with 2 1/2" Alum. Cap.

Mkd. "U.S. P.C. PROPERTY COR. T255

RIW <sup>54 | 53</sup> 59 | 510 RE 4287 "on Top" 1964 "on N.

Edge, & New B.Ts 25 follows -

10" Fir N, 61° E, 89 ft.

Scribed "S3 BT"

6" Hemlock N, 11 1/2° W, 33° ft.

Scribed "S4 BT"

7" Hemlock S, 8 1/2° W, 139 ft.

Scribed "S9 BT"

15" R. Cedar S, 13 1/2° E, 34 1/2 ft.


Scribed "S10 BT"

We find no trace orig. Bts

This Cor. unrecorded.

Nov 7, 1966

VRT  
J.H.  
DW.  
C.L.S.

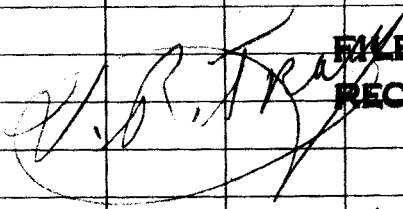

FILED  
RECEIVED

NOV 7 1966

COUNTY SURVEYOR  
DOUGLAS COUNTY, ORE.

X ✓ C.K. J.W.B. C.S. File No. 52/30-52