

Renew $\frac{1}{4}$ $\frac{534}{53}$ T245 RIW

Ed. B.T.'s 25 follows -

Orig. 24" Now 36" FIR N. 50° E. 28 $\frac{3}{4}$ ft.

we open. A find "B" scribe & Reverse alive

Orig. 42" Now 48" FIR S. 42° W. 23 $\frac{1}{2}$ ft.

Alive - shows good scar. Set 1"

I.P. & BRASS cap MKd. "COUNTY

SURVEYOR'S OFFICE 1966 T245

$\frac{1}{4}$ $\frac{534}{53}$ T255 RIW " & MK. New B.T.'s

12" Hemlock N. 31° W. 9 $\frac{2}{4}$ ft.

Mkd. " $\frac{1}{4}$ 534 CS BT "


8" Hemlock S. 2° W. 3 $\frac{3}{4}$ ft.

Mkd. " $\frac{1}{4}$ 53 CS BT "

This cor. lies North of Grizzly
Creek approx. 250 ft. ON Bench.

Nov. 10, 1966

U.R.T.
J.H.
D.W.
F.J.
C.L.S.

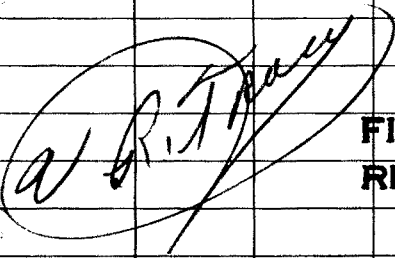

FILED
RECEIVED

NOV 10 1966

COUNTY SURVEYOR
DOUGLAS COUNTY, ORE.

* T25 - 498
* T24 - 462

C.S. File No. 52/30-56