

Renew $\frac{1}{4}$ $\frac{S36}{S1}$ T245 R1W
T255

Fd. BTs 25 follows -

ORIG. 12" NOW 23" FIR S. 70° E. 11 $\frac{3}{4}$ ft. (slope)

opened & shows "BT" scribe - alive

ORIG. 24" NOW 30" FIR N. 75° W. 10 $\frac{6}{8}$ ft (Level)

shows good SCAR - do not open - alive.

we find NO TRACE of stone called for,

Set 1" I.P. & BRASS CAP MKD. COUNTY

SURVEYORS OFFICE 1966 T245

$\frac{1}{4}$ $\frac{S36}{S1}$ T255 R1W " in mound of stone.

MK. New BTs -

24" D. FIR S. 20° W. 35 $\frac{3}{4}$ ft.

MKD. $\frac{1}{4}$ S1 CS BT"


7" Laurel N. 4° W. 19 $\frac{3}{4}$ ft.

MKD. $\frac{1}{4}$ S36 CS BT"

This COR. Lies on South side of
"small" creek course S.W. ON VERY
steep westerly slope in area of
several small pines.

Nov. 17, 1966

V.R.T.
J.H.
D.W.

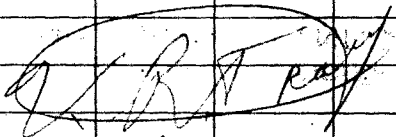

* #99-125
#63 - T24

C. S. File No. 52/30-59