


Renew $\frac{1}{4}$ $\frac{59}{516}$ T255 RIW
 Fd. Orig. Stone with Partial chisel
 MKs. only & BT's 25 Follows -
 Orig: 15" Now 22" FIR S. 25° W 36³ ft.
 Down & Dead - scribe visible on
 opened Blaze, Ren. # 32 BTs -
 10" Now 14" Hemlock N. 45° E. 38⁸ ft.
 Shows " $\frac{1}{4}$ 59 253 BT" scribe on
 Unhealed Blaze, alive
 20" Now 24" cedar S. 71 $\frac{1}{2}$ ° E. 39° ft
 Shows " $\frac{1}{4}$ 516 253 BT" scribe on
 Unhealed Blaze, alive - Set 1"
 I.P. & BRASS cap MKd. COUNTY
 SURVEYOR'S OFFICE 1966
 T255 $\frac{1}{4}$ $\frac{59}{516}$ RIW" - do not
 MK. new BTs - This cor. lies
 approx. 32 ft West of small
 creek, course South.

Nov. 18, 1966

FILED U.P.T.
 J.H.
 RECEIVED

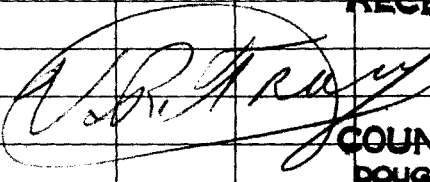

NOV 18 1966

COUNTY SURVEYOR
DOUGLAS COUNTY, ORE.

#100 O.K. J.W.B.

C.S. File No. 52/30-64