

Review $\frac{1}{4}$ $\frac{516}{521}$ T255 RIW

Fd. $1\frac{1}{2}$ " I.P. 30" Long Loosely Set
FOR COR. - UNRECORDED, & B.T.S. as follows
ORIG. 6" NOW 9" CEDAR S. 4° W. 5^3 FT.
DOWN FACE BURNED - FRAGMENTARY SCRIBE
& REVERSE.

ORIG. 8" NOW 9" CEDAR N. 39° W. 9^2 FT.
Dead - FACE BURNED - ONLY AXE MKS. Fd.
set 1" I.P. & BRASS CAP MKD "COUNTY
SURVEYOR'S OFFICE 1966 T255

$\frac{1}{4}$ $\frac{516}{521}$ RIW "Reset I.P. alongside - MK. NEW B.T.S. -
60" D. FIR (STUMP) N. 18° E. $47^{\frac{1}{2}}$ FT.
MKD. " $\frac{1}{4}$ 516 CS BT"

9" CEDAR (SNAG) N. 63° E. 21^3 FT.
MKD. " $\frac{1}{4}$ 516 CS BT"


48" D. FIR (STUMP) S. 82° W. 43^5 FT.
MKD. " $\frac{1}{4}$ 521 CS BT"

This COR. LIES IN LARGE
CUTOFF AREA ON TOP OF SMALL SPUR
SLOPING WEST CURVING TO SW.

FILED

Nov. 18, 1966 RECEIVED, R.T.

J.H.
NOV 4 1966

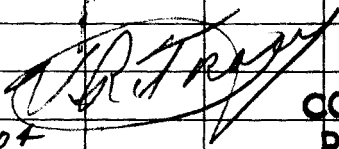

COUNTY SURVEYOR
DOUGLAS COUNTY, ORE.

D.M. J.W.B.

C.S. File No. 5230-65