

Renew Sec. Cor. <sup>531</sup> 532 T245 RIW  
<sup>56</sup> 55 T255

Fd. one BT. still in place as follows -  
ORIG. 12" Now 17" F.I.R. S. 87 1/2 ° W, 46 1/2 ft.

Now stump - we open & find "56 RIW"  
scribed & Reverse. Bearings & approx.  
distances fit holes of other ORIG.

B.T.s, down & out of position. Set  
1" I.P. & BRASS cap MKd. "COUNTY  
SURVEYOR'S OFFICE 1966 T245

<sup>531</sup> 532 T255 RIW " & MK New B.T.s -  
<sup>56</sup> 55  
6" Hemlock N. 73 ° W, 52 ° ft.

Mkd. "T245 RIW 531 CS BT"  
12" Yew S. 66 1/2 ° W, 16 1/2 ft.

Mkd. "T255 RIW 56 CS BT"  
11" Yew S. 25 ° E, 24 1/4 ft.

Mkd. "T255 RIW 55 CS BT"  
8" Hemlock N. 29 ° E, 59 1/2 ft.

Mkd. "T245 RIW 532 CS BT"  
This cor. Lies on NE. Slope  
in Logged unit.


FILED

Nov. 30, 1966

RECEIVED

J.H.

NOV 30 1966

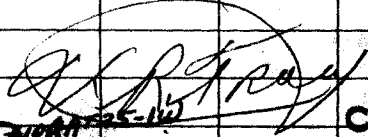

COUNTY SURVEYOR  
DOUGLAS COUNTY, ORE.

2660

C. S. File No. 5230-49