

Renew $\frac{1}{4}$ S36 of T255 R2W only

Fd. O.B.T.S 25 follows -

ORIG. 6" Now 10" Hemlock S. 55° W, 145 ft.

alive & chopped open showing
" $\frac{1}{4}$ S36 " scribed & unopened lower scar.

ORIG. 14" Fir S. 88° E, 145 ft.

Now Down & Badly decayed - find edge
of old axe face.

Set 1" IP & BRASS cap MKd. "COUNTY
SURVEYOR'S OFFICE 1967 T255

R2W $\frac{1}{4}$ S36 | R1W " & MK. New B.T.S -
17" Hemlock S. 47° W, 352 ft.

Mkd. " $\frac{1}{4}$ S36 CS BT "


8" Hemlock N. 46° W, 208 ft.

Mkd. " $\frac{1}{4}$ S36 CS BT "

This cor. Lies 50 ft. East of
CREEK course S.

May 31, 1967

VRT,
J.H.
D.W.

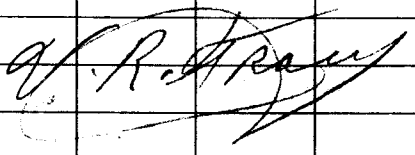

94123-R1W O.K. J.W.D.

* 81

C.S. File No. 52/30-85