

REVIEW MC 13 T262 ROW
LT BRASS 246

FOUND - ORIG. 45" NOW 27" BRASS
N 72° W 80.1' T. OPEN. FIND
GOOD SCRIBING "T" ORIG. SW AT
CORNER.

NOTE - MC IS IN FLOOD AREA
NEAR SET WIT COR. 40' WEST OF
TRAIL CORNER.

SET BRASS CAP AT CORNER
MARKED COUNTY SURVEYORS
OFFICE 1960. WIT COR. 40'
EAST TO MC. ~~S 22° T 262 ROW~~
~~S 22°~~

NEW RTS.

11" W.O. BEARS N 52° W 12.0'
SCRIBED MC MC S 13 CS BT

12" W.O. BEARS S 85° W 4.0'
SCRIBED W C MC CS 3 24 BT

VAR 20 1/2°

AUG. 2 - 1960
L. J.
M. G.
D. D.

REFER TO M19-4

DIETZGEN NO. 388-6


*

C.S. File No. 53/36

FILED
RECEIVED

AUG 8 1980

COUNTY SURVEYOR
DOUGLAS COUNTY, ORE

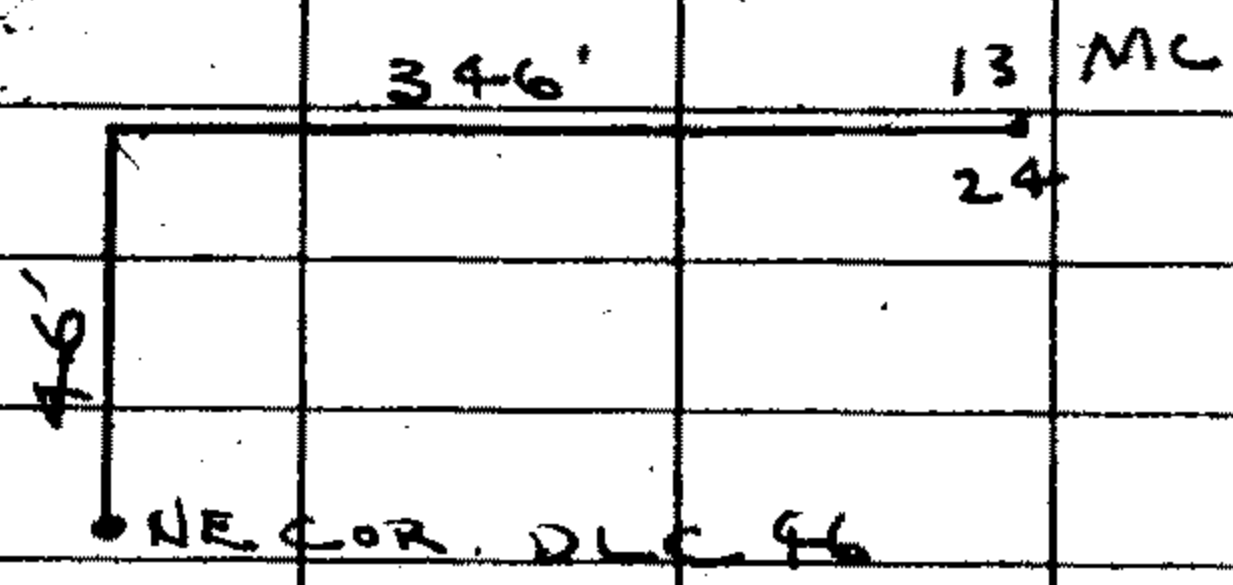

A.J. YOUNG

WIT COR.
NE COR.
D.L.C. 46
FD. BRASS CAP

564°W

64 L

1

23°14' L

587°W L 2770

396.94

12°50'
98 E

WIT COR.
M.C. 13
24
BRASS CAP