

Review $\frac{1}{4}$ S 26° E T 245 RIW

• Ed. at COR Both BT's & Brass
stone, 6" x 8" x 12" set firmly in
the ground MKD $\frac{1}{4}$ "

16" Now 24" Cedar N. 25° E. 17 $\frac{1}{2}$ ft.

Shows very good SCARS - we do not open.

36" Now 40" cedar S. 15° W. 16 $\frac{1}{2}$ ft.

Shows faint SCAR - we do not open.

We mark new BT's as follows.

6" Hemlock N. 72° E. 35 $\frac{1}{2}$ ft.

MKD. $\frac{1}{4}$ S 26 CS BT"

8" Hemlock S. 26° W. 81 $\frac{1}{4}$ ft.

MKD. $\frac{1}{4}$ S 35 CS BT"

No BRASS cap was set at this
time as Road stakes would take
CORNER out - BRASS cap will
be set at later date.

Dec. 8, 1964

V.R.T.
M.D.
J.B.

J.R. Tracy


PX
#37

C. S. File No.

52/42-32

Section 35 Twp 24S Rge W Date: 12 Nov 64

How was corner identified? Basalt Rock, scribed

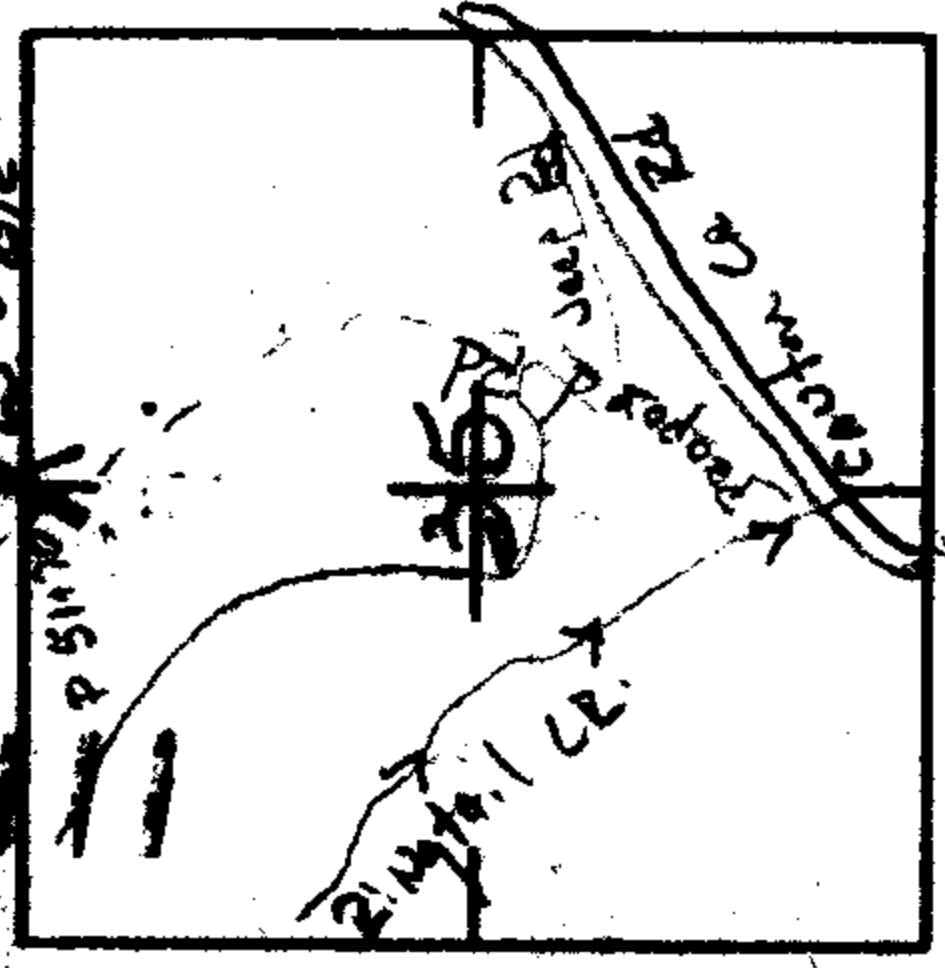

Condition of corner: Good

Best route to reach corner: located at STARS 1+70 on

Taped & staked Road (see sec. diagram)
Deep Road Not Passable

Quadrant	NE	NW	SE	SW
Species & Size	K" J. Cedar		40" J. Cedar	
Dist. & Bearing	10-15/K		10-15/K	
Condition of Scribe				
Original or Resurvey	original		original	
Appearance of B.T.	good		good	
Tags, Marks, etc.			Tag	

Other Remarks:

When setting New B.T.s
Note B.T.s relation
to Road

CS 52/42-32

Signed