

Renew $\frac{1}{4}$ S 24 $\frac{1}{2}$ 519 T24S RIW & RIE.
Ed. Both original B.T.'s as follows -
18" Now 28" FIR N. 30° E. 7 $\frac{1}{2}$ ft.
down & out of place we open
& find scribe marks

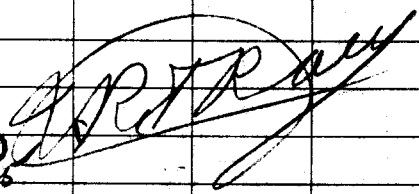
36" FIR Now 37" S 15° W. 10 $\frac{1}{2}$ ft.
Shows good scar - alive & in good
condition. NO TRACE of Rock
called for - We set 1" I.P.
& Brass Cap MKd. "COUNTY
SURVEYOR'S OFFICE 1965

T24S RIW $\frac{1}{4}$ S 24 $\frac{1}{2}$ 519 RIE" -
Cap is set under Root wad of
N.E. B.T. - We mark new B.T. -
22" D. FIR S. 78° E. 24 $\frac{1}{2}$ ft.
MKd. " $\frac{1}{4}$ S 19 CS BT"

This COR is on steep south
slope approx 300° ft from foot of
hill.

June 15, 1965

V.R.T.
T.C.


C. S. File No. 52/AB-33