

514 | 513
Renew Sec. COR. 523 | 524 T245 RIW

Fd. 12" x 10" x 8" Basalt Stone with 3
Notches on on South side & 1 notch on
East side & BT's as follows -

ORIG. 8" Now 16" FIR N26°E 17² ft. 2 live
Shows very good SCAR - we do not open.

ORIG. 8" Now 17" FIR S. 48°E. 13⁹ ft. 2 live
Shows very good SCAR - we do not open.

ORIG. 30" Now 33" FIR S. 53°W. 17⁸ ft.
Now SN 29 - shows "T24 RIW 52 BT"
SCRIBER on unhealed blaze.

ORIG. 6' Now 7" FIR N. 48°W. 21⁸ ft. 2 live
Shows good SCAR - we do not open -
Set 1" I.P. & BRASS COP MKD. "COUNTY

SURVEYORS OFFICE 1966 T245

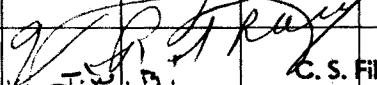
514 | 513
523 | 524 RIW " IN MOUND OF Stone 3 ft.
wide at Base & 2 ft. high & set ORIG
Stone along side. - MARK New BT. -

8" D. FIR S. 50°W. 11⁰ ft.
MKD. "T245 RIW 523 CS BT"

This COR. Lies approx 300 ft West
of top of Ridge course N. & S.

V.R.T.
J.H.

Sept 20, 1966

536
* 
O.K. J.W.D.

C.S. File No. 52/42-46