


Section 24

Tap 24S Age 2

Date: 6-15-67

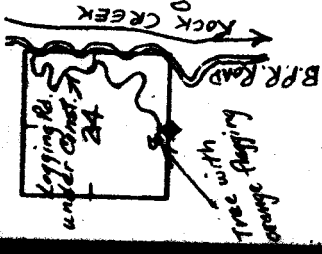

How was corner identified? 3 Orig. Laurel B.T.'s and Stone  
with 2 notches. Could not find "MS" on stone.

Condition of corner: FAIR TREE. NO R. NOR D. WE FIND N.D. STONE  
ON BEARING DOES NOT CHECK. INSUFFICIENT EVIDENCE TO RENEW 6/22/67 ERP

Best route to reach corner: logging road to left. Take  
growing on small rock outcrop on left side of road. (Orange  
flagging on tree.) From here go S down ridge approx.  
400' to Corner.

Quadrant	NE	NW	SE	SW	Other Remarks:
Species & Size	Laurel 14"			Laurel/RECEIVED	Orig. E-W line bleazes go
Dist. & Bearing	N78°E 10 kfs.			578°W 13 kfs.	to this corner. Found
Condition of Scribe	Gone			Gone	2 notches on scribe but did
Original or Recovery	Orig.				not find "MS" on it. B.T.s.
Appearance of B.T.	Good				COUNTY SURVEYOR
Flags, marks, etc.	014 2x6 MARKS				Good DO NOT RE-COUNTY STONE.

*Richard L. Frank*

C. S. 5/22-5