


Fd. aK. T265 R2E

COR. #2 HES. 93

See Ren #13 $1\frac{1}{2}$ " I.P. & OBT. + New BT.
New BT. To NW gone completely -
I.P. is in "Y" of Driveway - See Below.

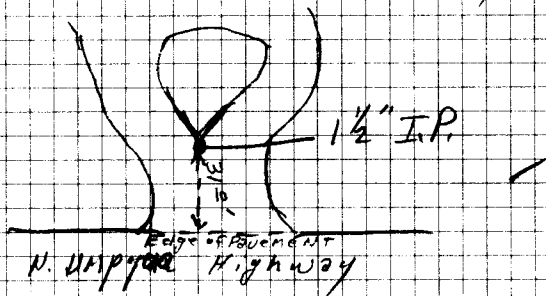

COR. #4 HES 93 -

N.F. THIS VISIT -

DIETZGEN NO. 385-6